


CALLISTO VIEWS - LOT 1

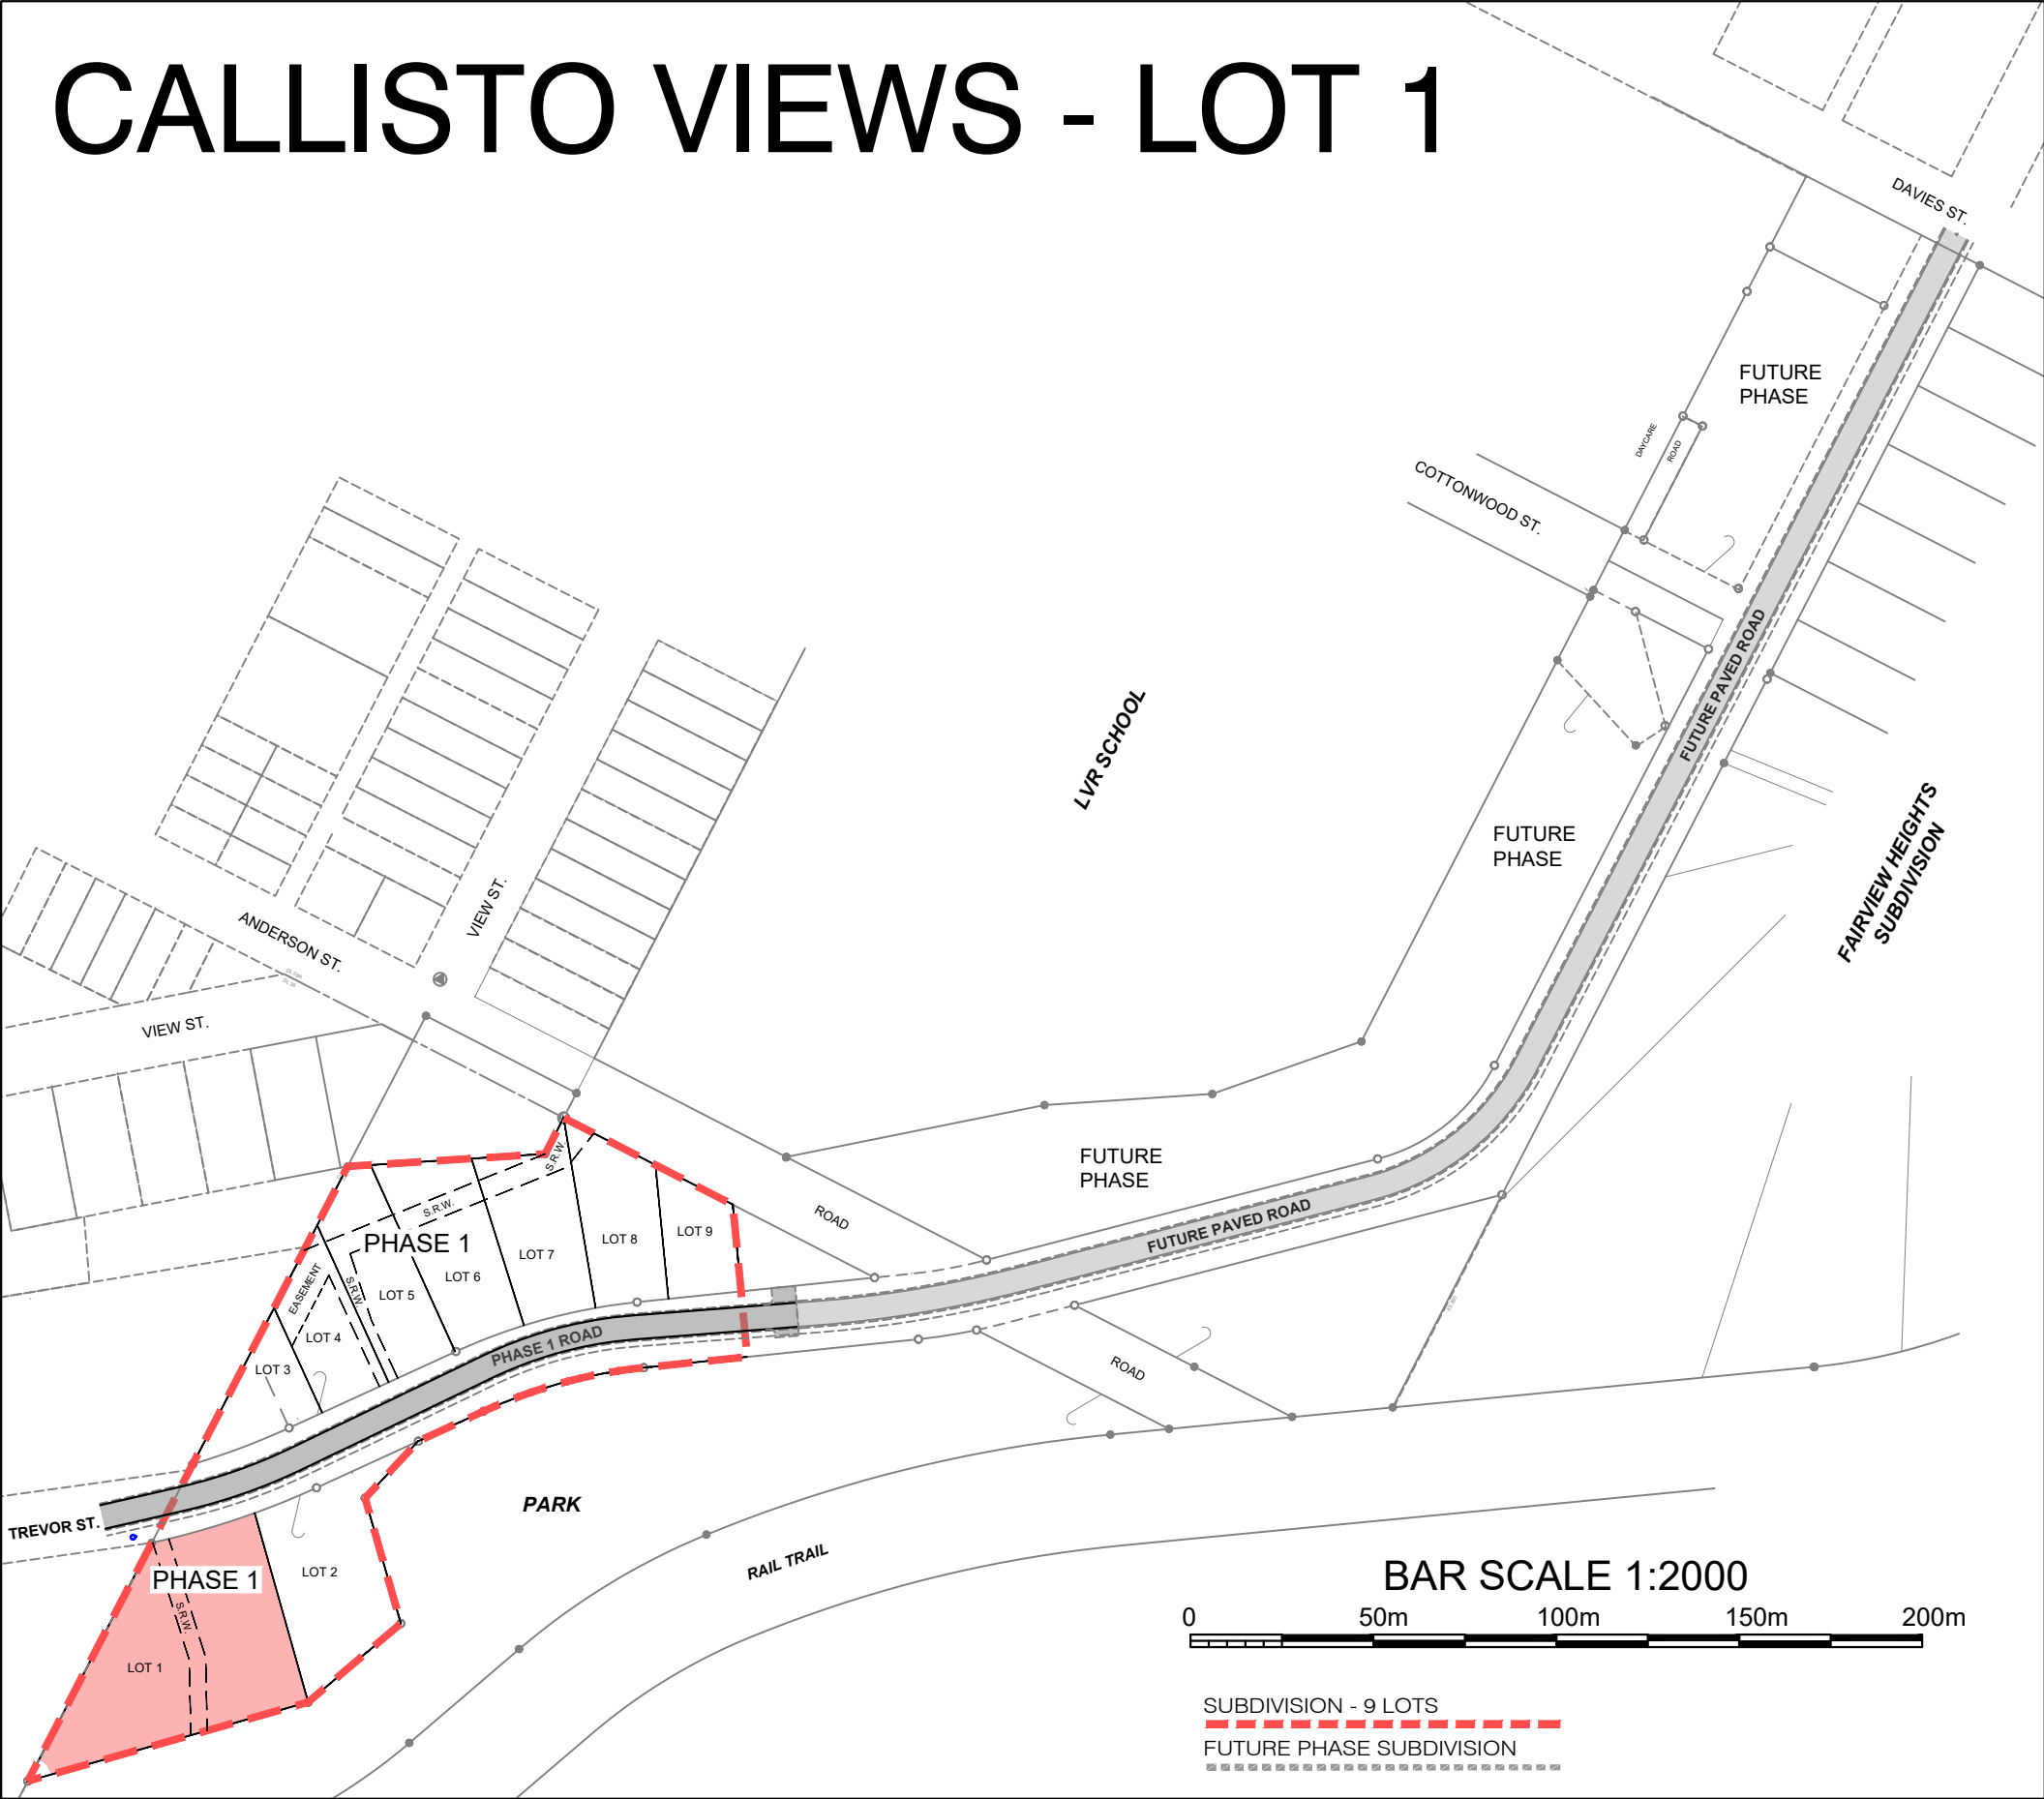

SUITE #3, 385 BAKER STREET
NELSON, BC V1L 4H6


PH (250) 354-7683
email: info@snteng.ca

**FOR INFORMATION
ONLY**
2026/09/25

DRAWING INDEX:

- 1000 LOT 1 - PLAN VIEW w/ 1m CONTOURS
- 1001 LOT 1 - AS-BUILT GROUNDLINE PROFILE (1:250)
- 1002 LOT 1 - AS-BUILT GROUNDLINE PROFILE (1:150)


SUBDIVISION LEGAL DESCRIPTION:
LOT A, PLAN EPP143242 DL183

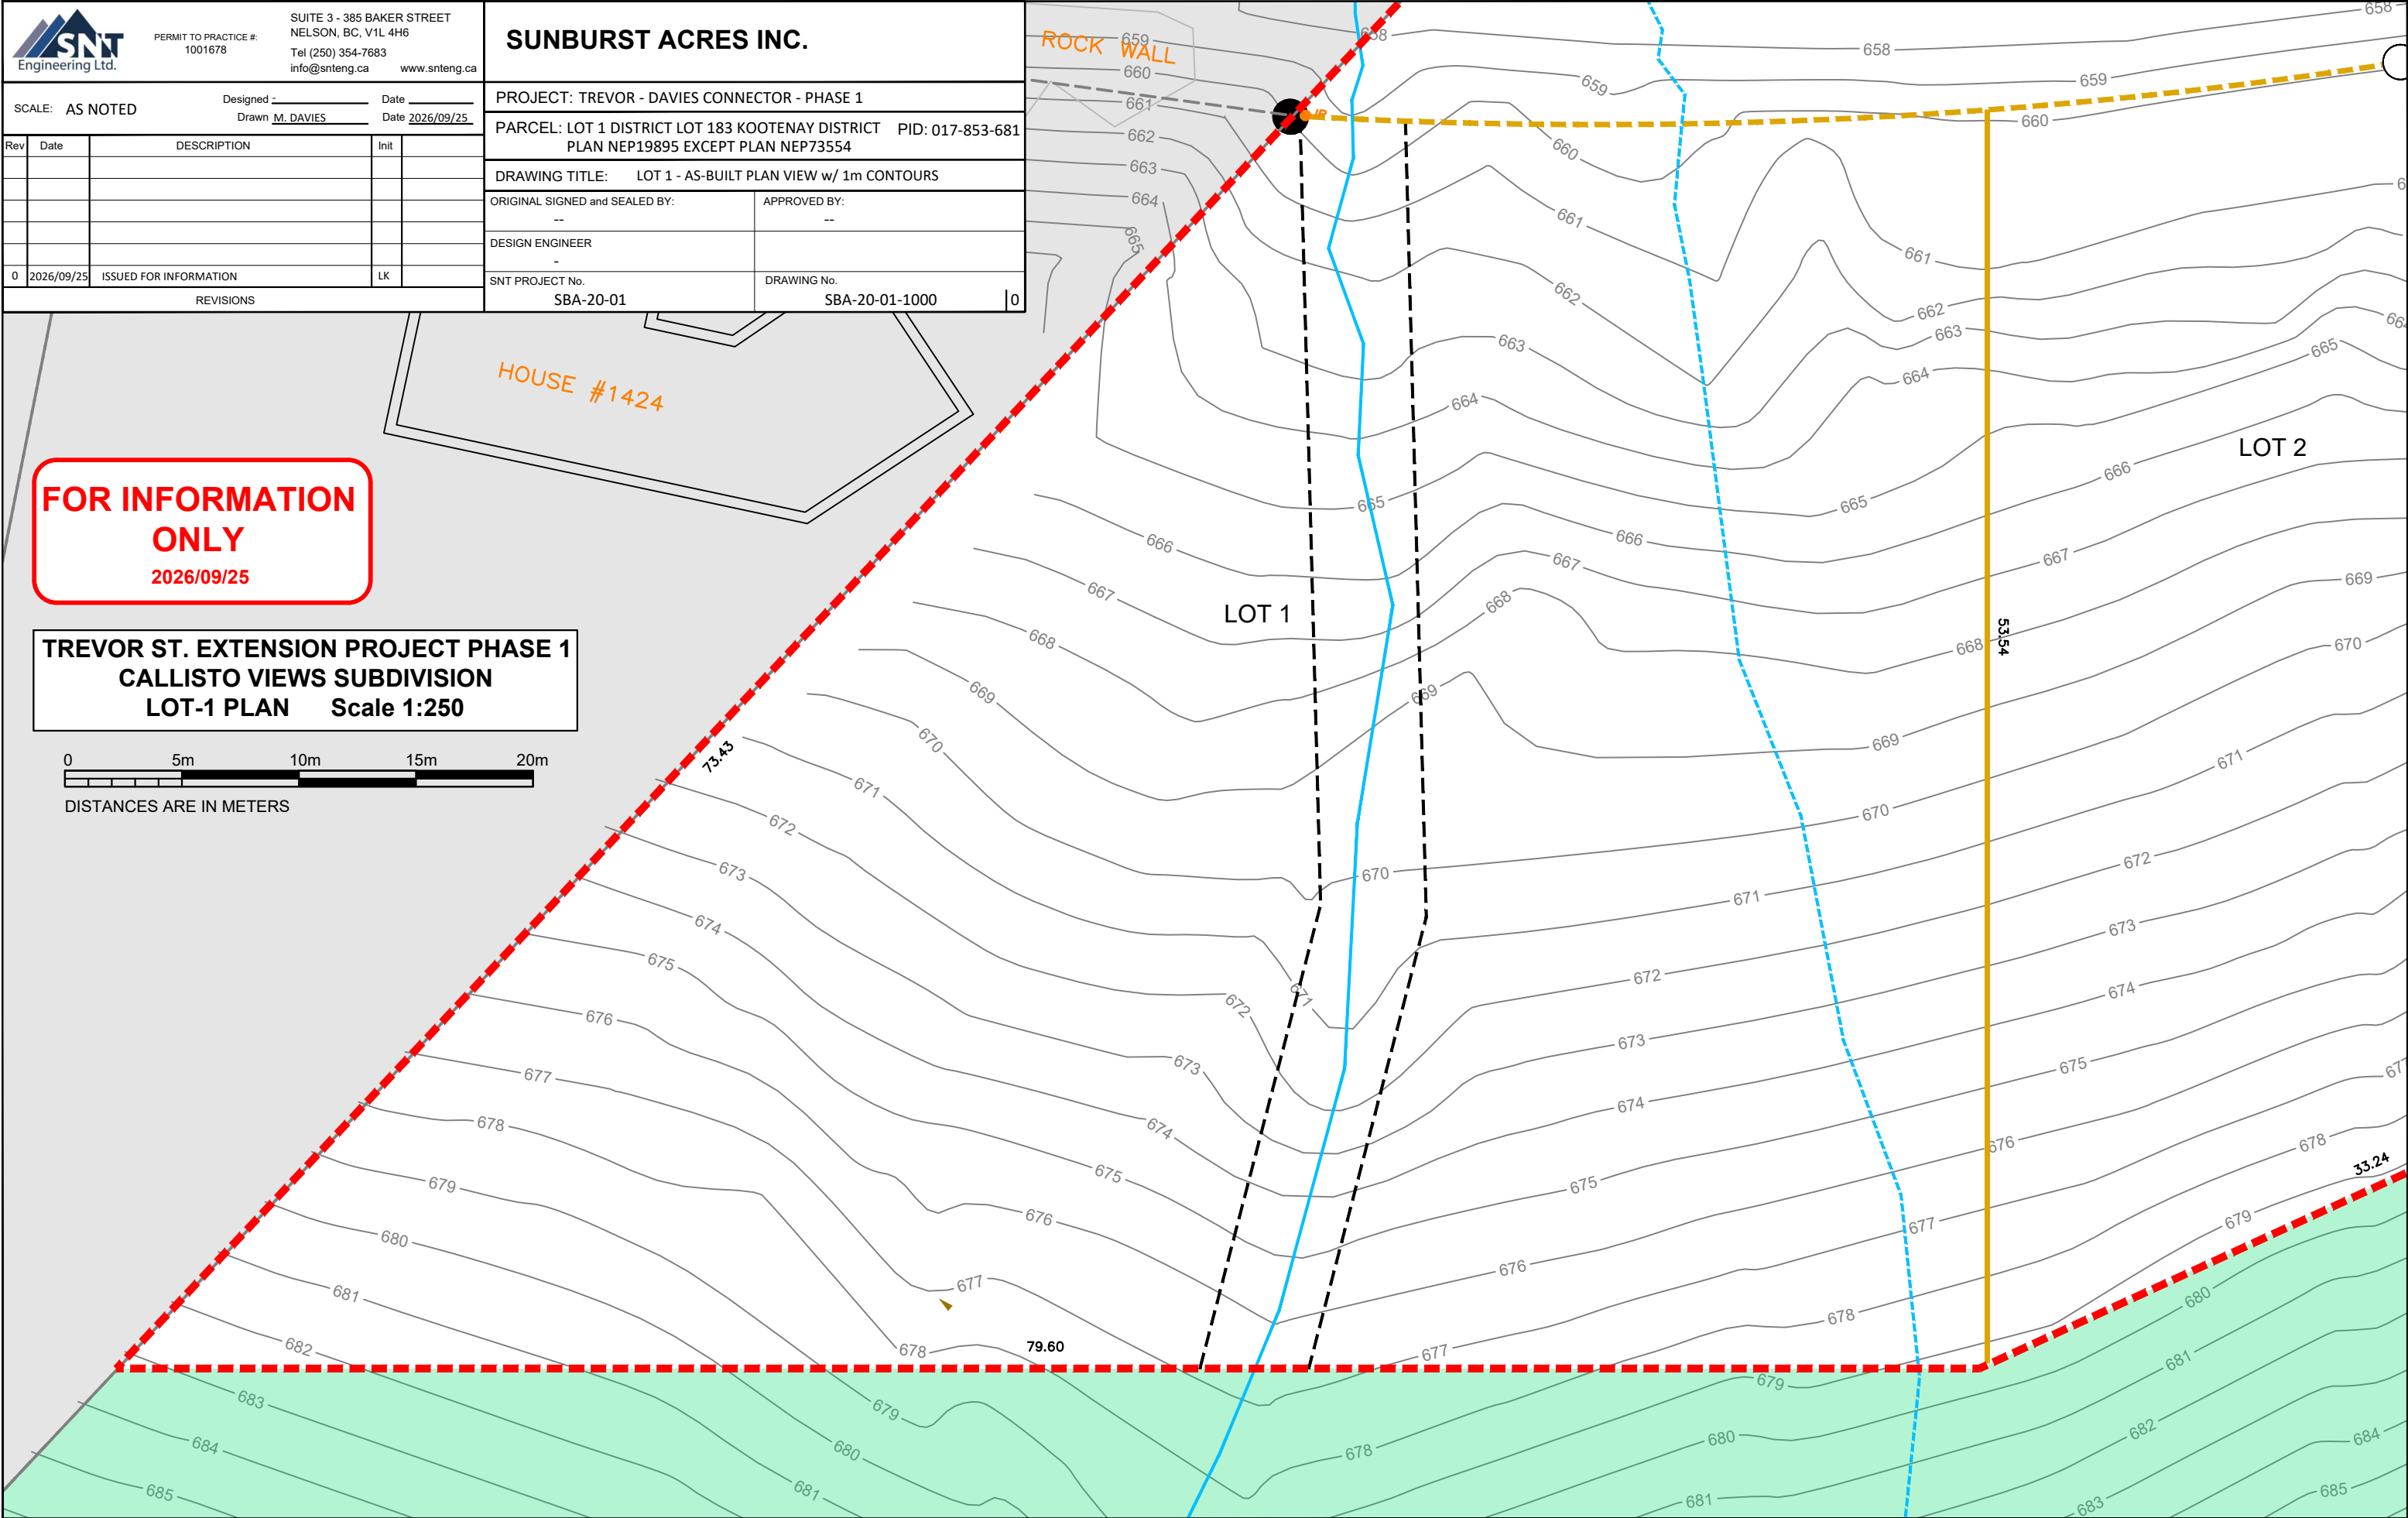

		PERMIT TO PRACTICE #: 1001678		SUNBURST ACRES INC.	
		SUI TE 3 - 385 BAKER STREET NELSON, BC, V1L 4H6 Tel (250) 354-7683 info@snteng.ca www.snteng.ca			
SCALE: AS NOTED		Designed - Drawn M. DAVIES		Date Date 2026/09/25	
Rev	Date	DESCRIPTION	Init		
0	2026/09/25	ISSUED FOR INFORMATION	LK		
REVISIONS					
				PROJECT: TREVOR - DAVIES CONNECTOR - PHASE 1	
				PARCEL: LOT 1 DISTRICT LOT 183 KOOTENAY DISTRICT PID: 017-853-681 PLAN NEP19895 EXCEPT PLAN NEP73554	
				DRAWING TITLE: LOT 1 - AS-BUILT GROUND PROFILE	
				ORIGINAL SIGNED and SEALED BY: APPROVED BY:	
				DESIGN ENGINEER --	
				SNT PROJECT No. DRAWING No.	
				SBA-20-01 SBA-20-01-1001	
				0	

FOR INFORMATION
ONLY
2026/09/25

TREVOR ST. EXTENSION PROJECT PHASE 1
CALLISTO VIEWS SUBDIVISION
LOT-1 PROFILE Scale 1:250

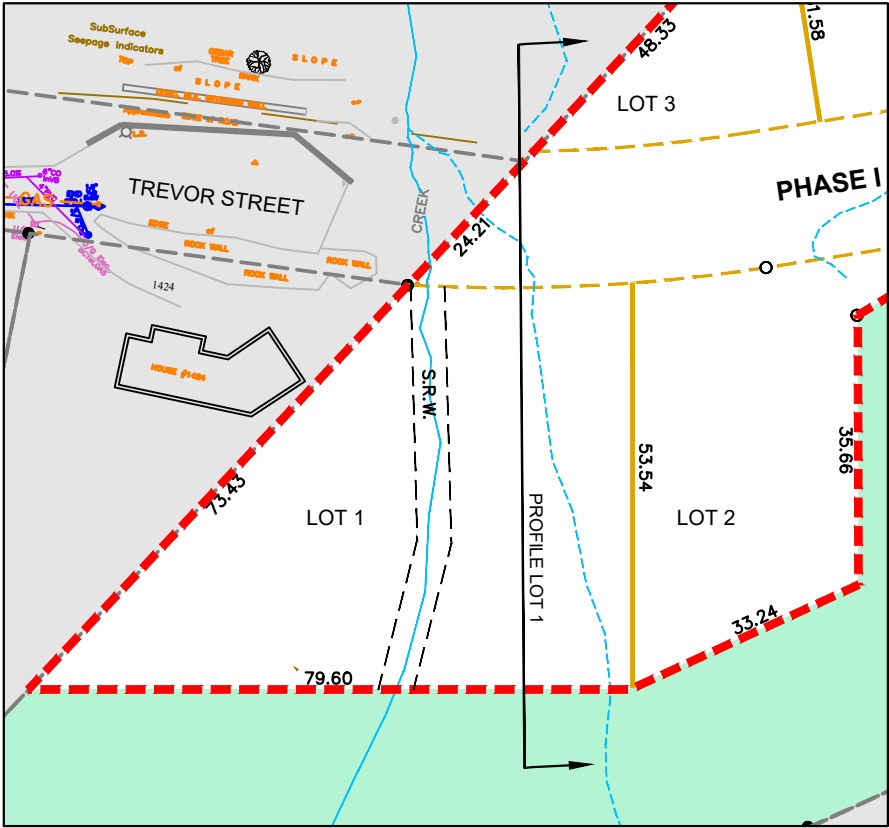

PLAN VIEW OF LOT 1 scale 1:1000

