


CALLISTO VIEWS - LOT 3

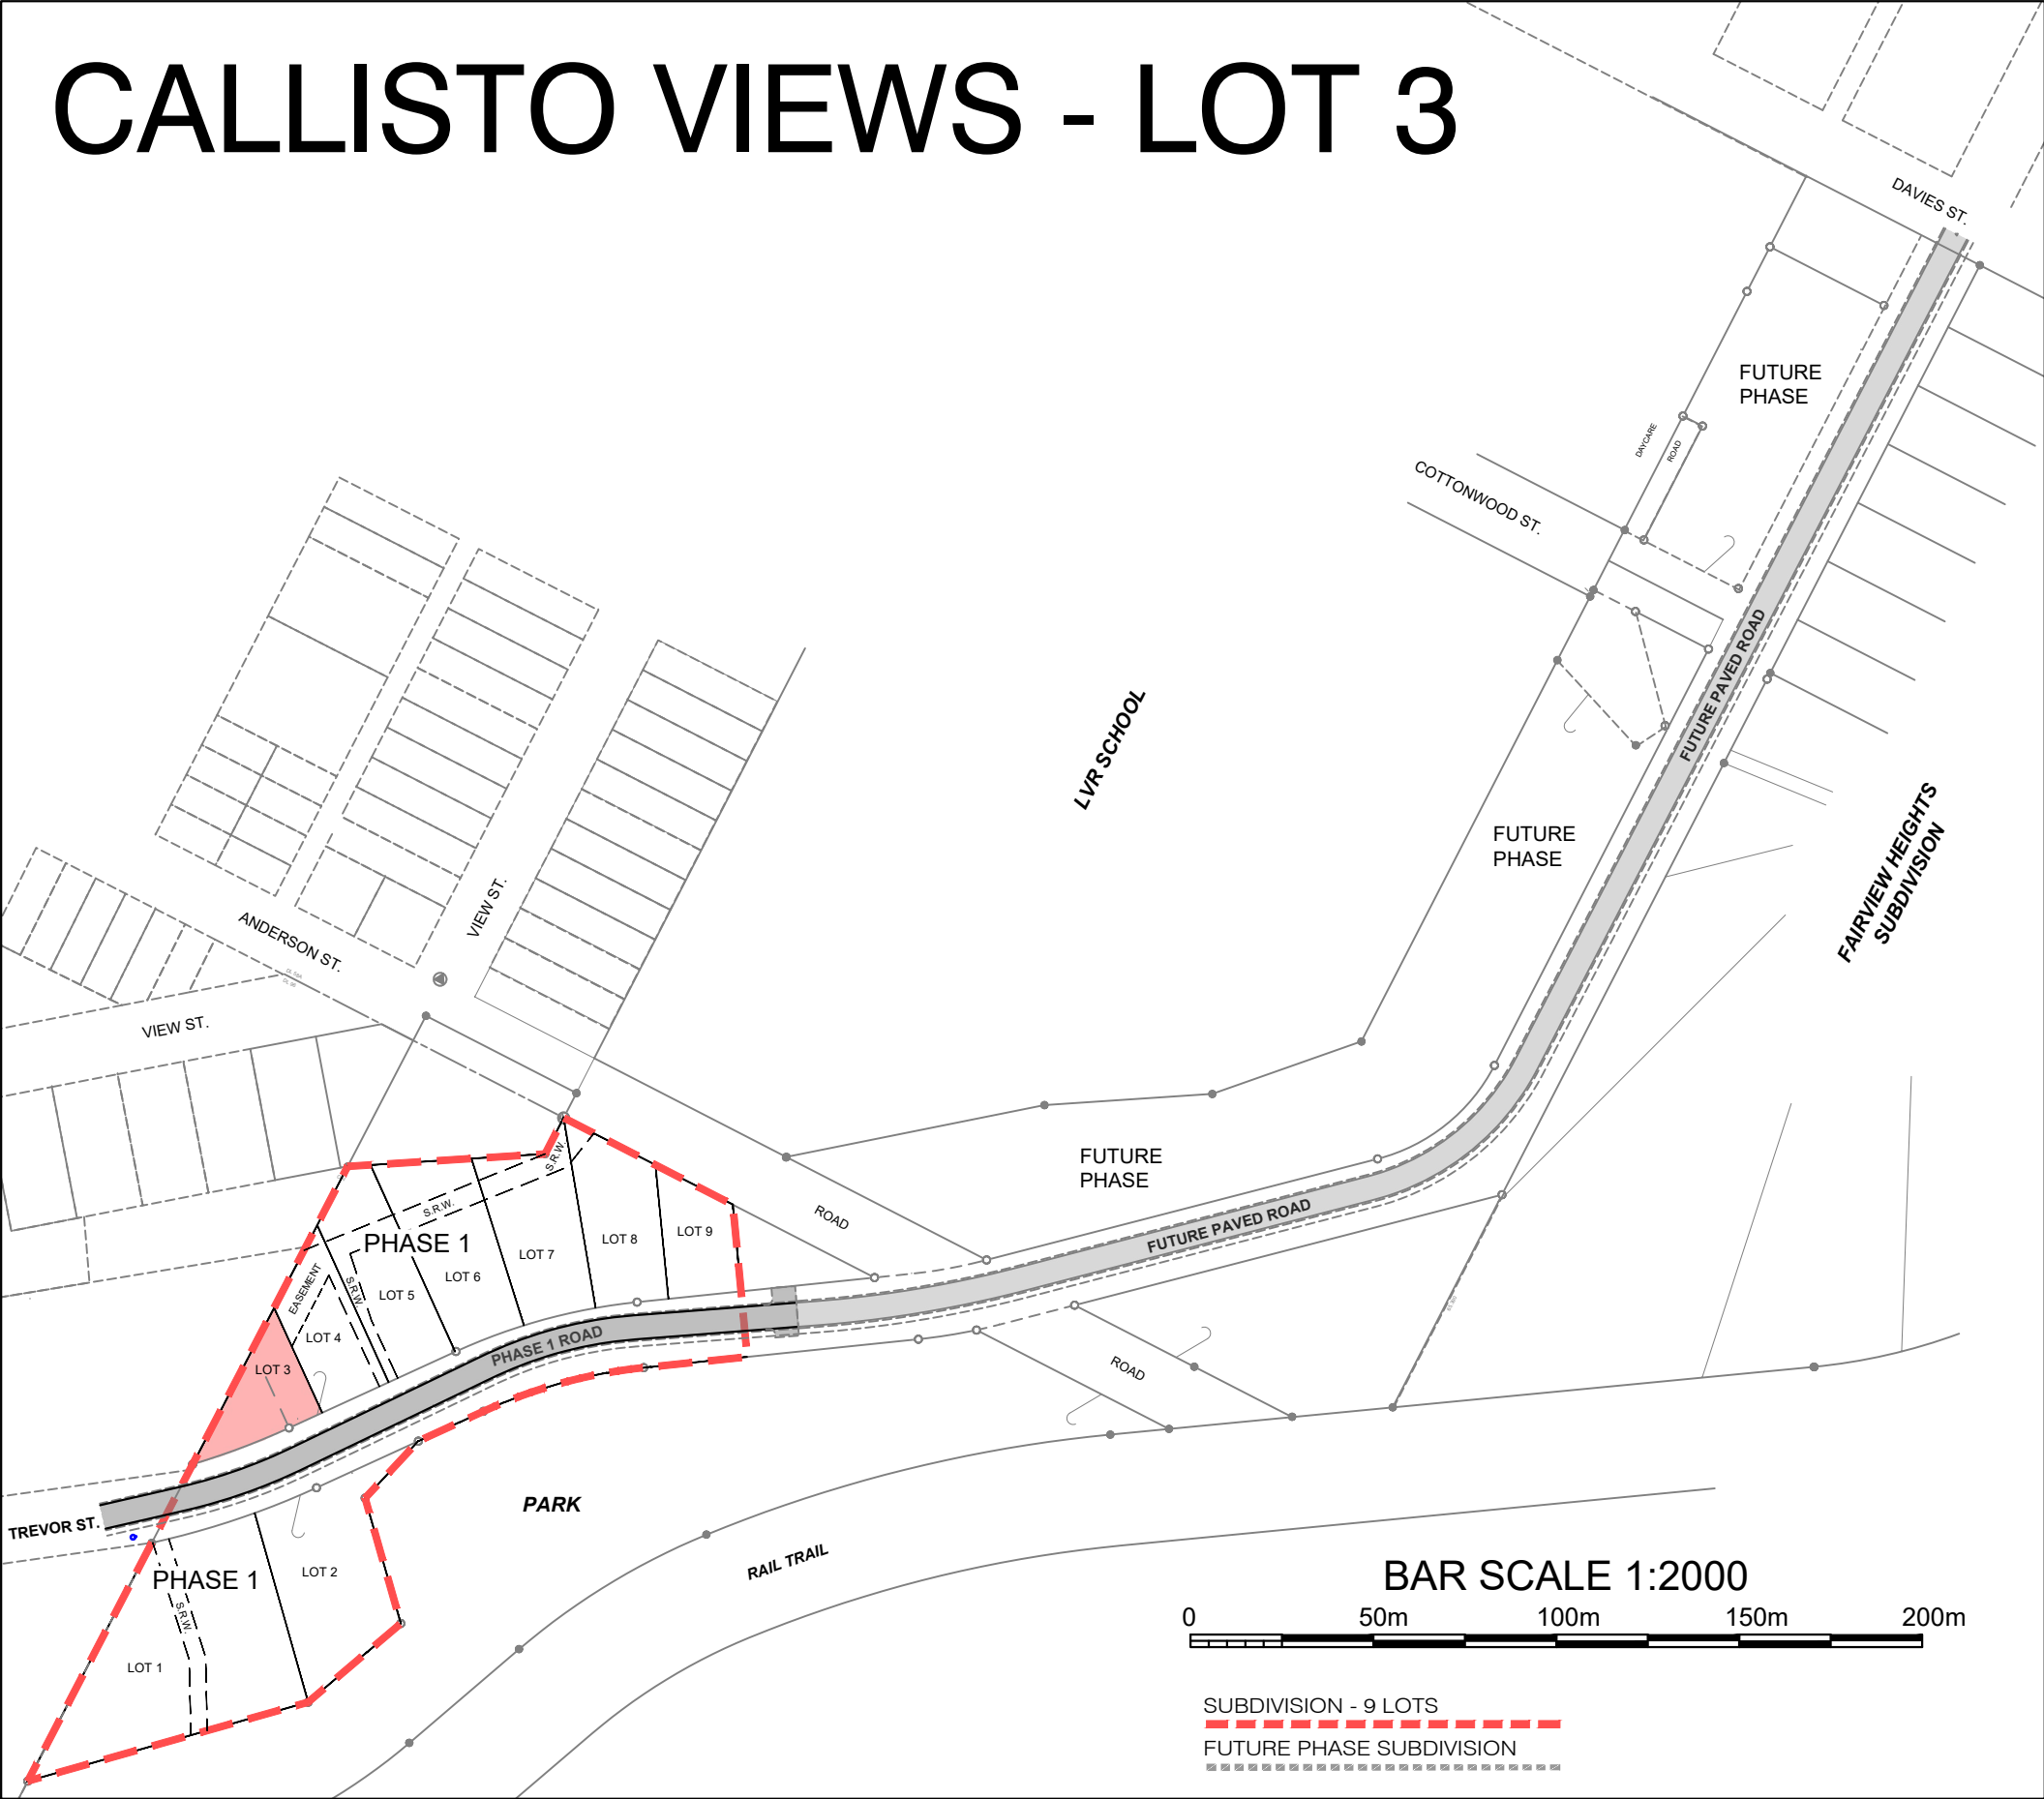

SUITE #3, 385 BAKER STREET
NELSON, BC V1L 4H6

PH (250) 354-7683
email: info@snteng.ca

**FOR INFORMATION
ONLY**
2026/09/25

DRAWING INDEX:


- 3000 LOT 3 - PLAN VIEW w/ 1m CONTOURS
- 3001 LOT 3 - AS-BUILT GROUNDLINE PROFILE (1:250)
- 3002 LOT 3 - AS-BUILT GROUNDLINE PROFILE (1:150)

SUBDIVISION LEGAL DESCRIPTION:
LOT A, PLAN EPP143242 DL183



10

Rev	Date	DESCRIPTION	Init	
0	2026/09/25	ISSUED FOR INFORMATION	LK	
REVISIONS				

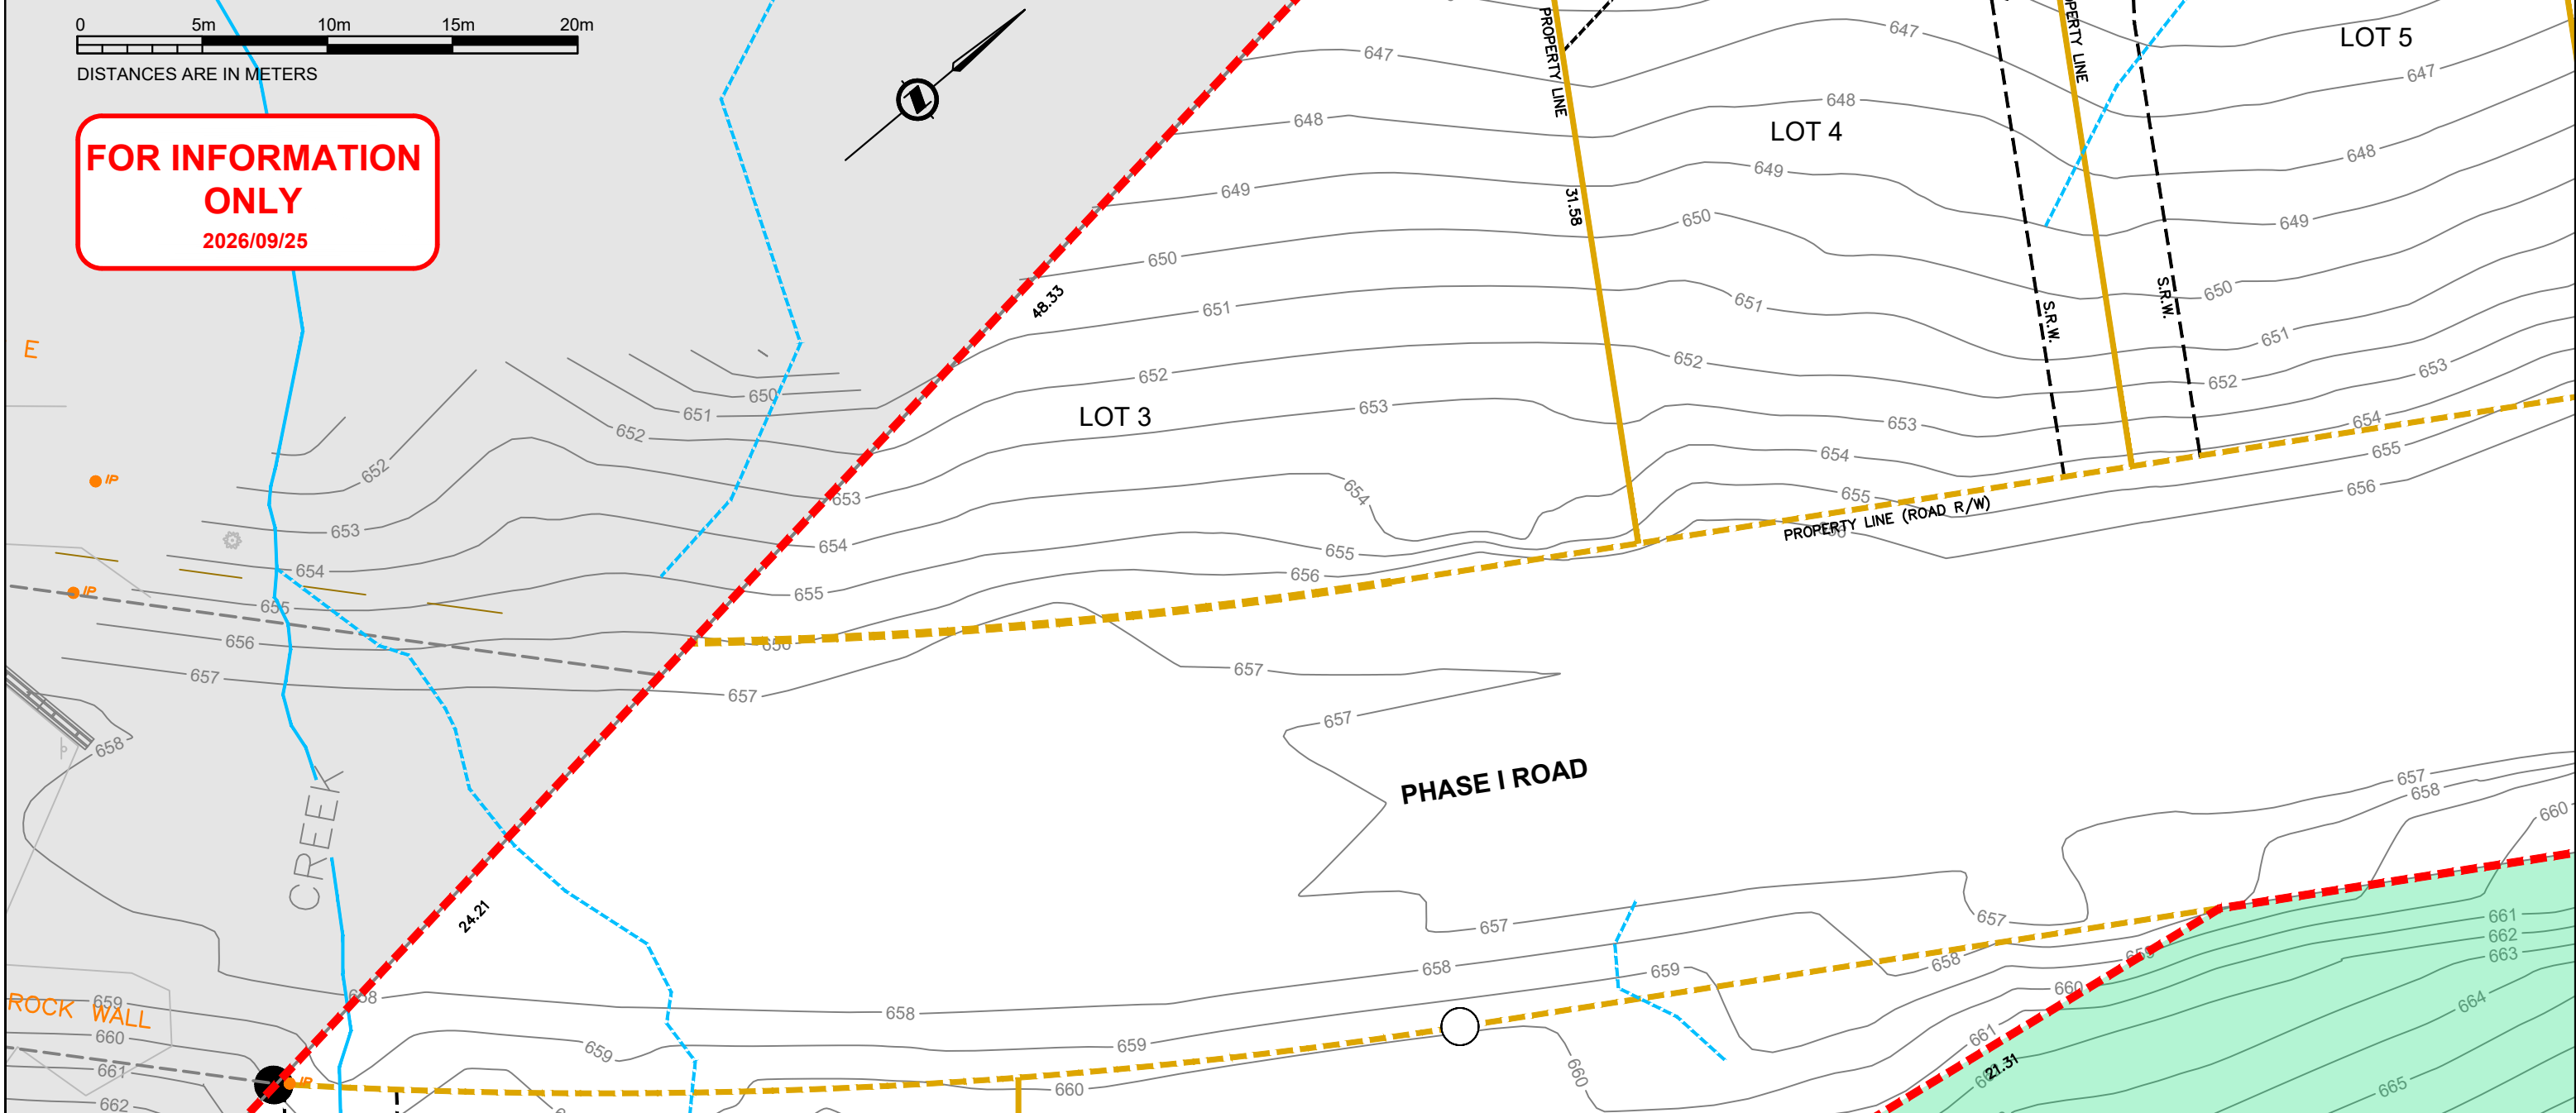

SUNBURST ACRES INC.

SCALE: AS NOTED

Designed by

Drawn M. DAVIES

Date _____

Date 2026/03/16

PROJECT: TREVOR - DAVIES CONNECTOR - PHASE 1

PARCEL: LOT 1 DISTRICT LOT 183 KOOTENAY DISTRICT PID: 017-853-681
PLAN NEP19895 EXCEPT PLAN NEP73554

DRAWING TITLE: LOT 3 - AS-BUILT GROUND PROFILE

ORIGINAL SIGNED and SEALED BY:

APPROVED BY:

DESIGN ENGINEER


SNT PROJECT No.

DRAWING No.

SBA-20-01-3001

**FOR INFORMATION
ONLY**
2026/09/25

TREVOR ST. EXTENSION PROJECT PHASE 1
CALLISTO VIEWS SUBDIVISION
LOT-3 PROFILE Scale 1:250

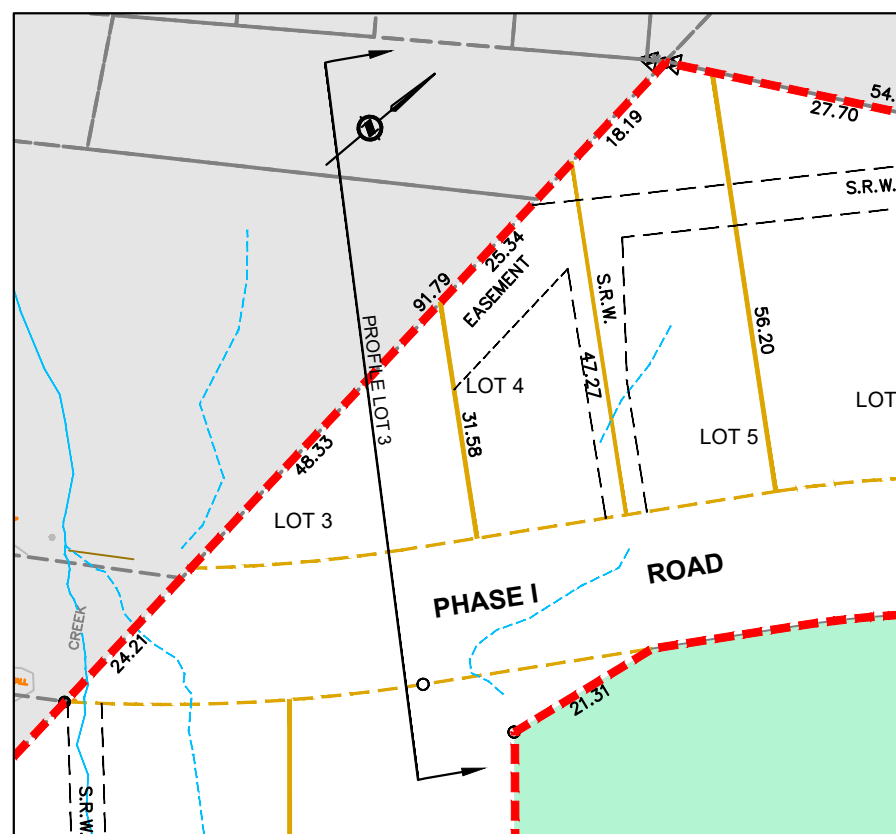

PLAN VIEW OF LOT 3

scale 1:1000

