


CALLISTO VIEWS - LOT 5

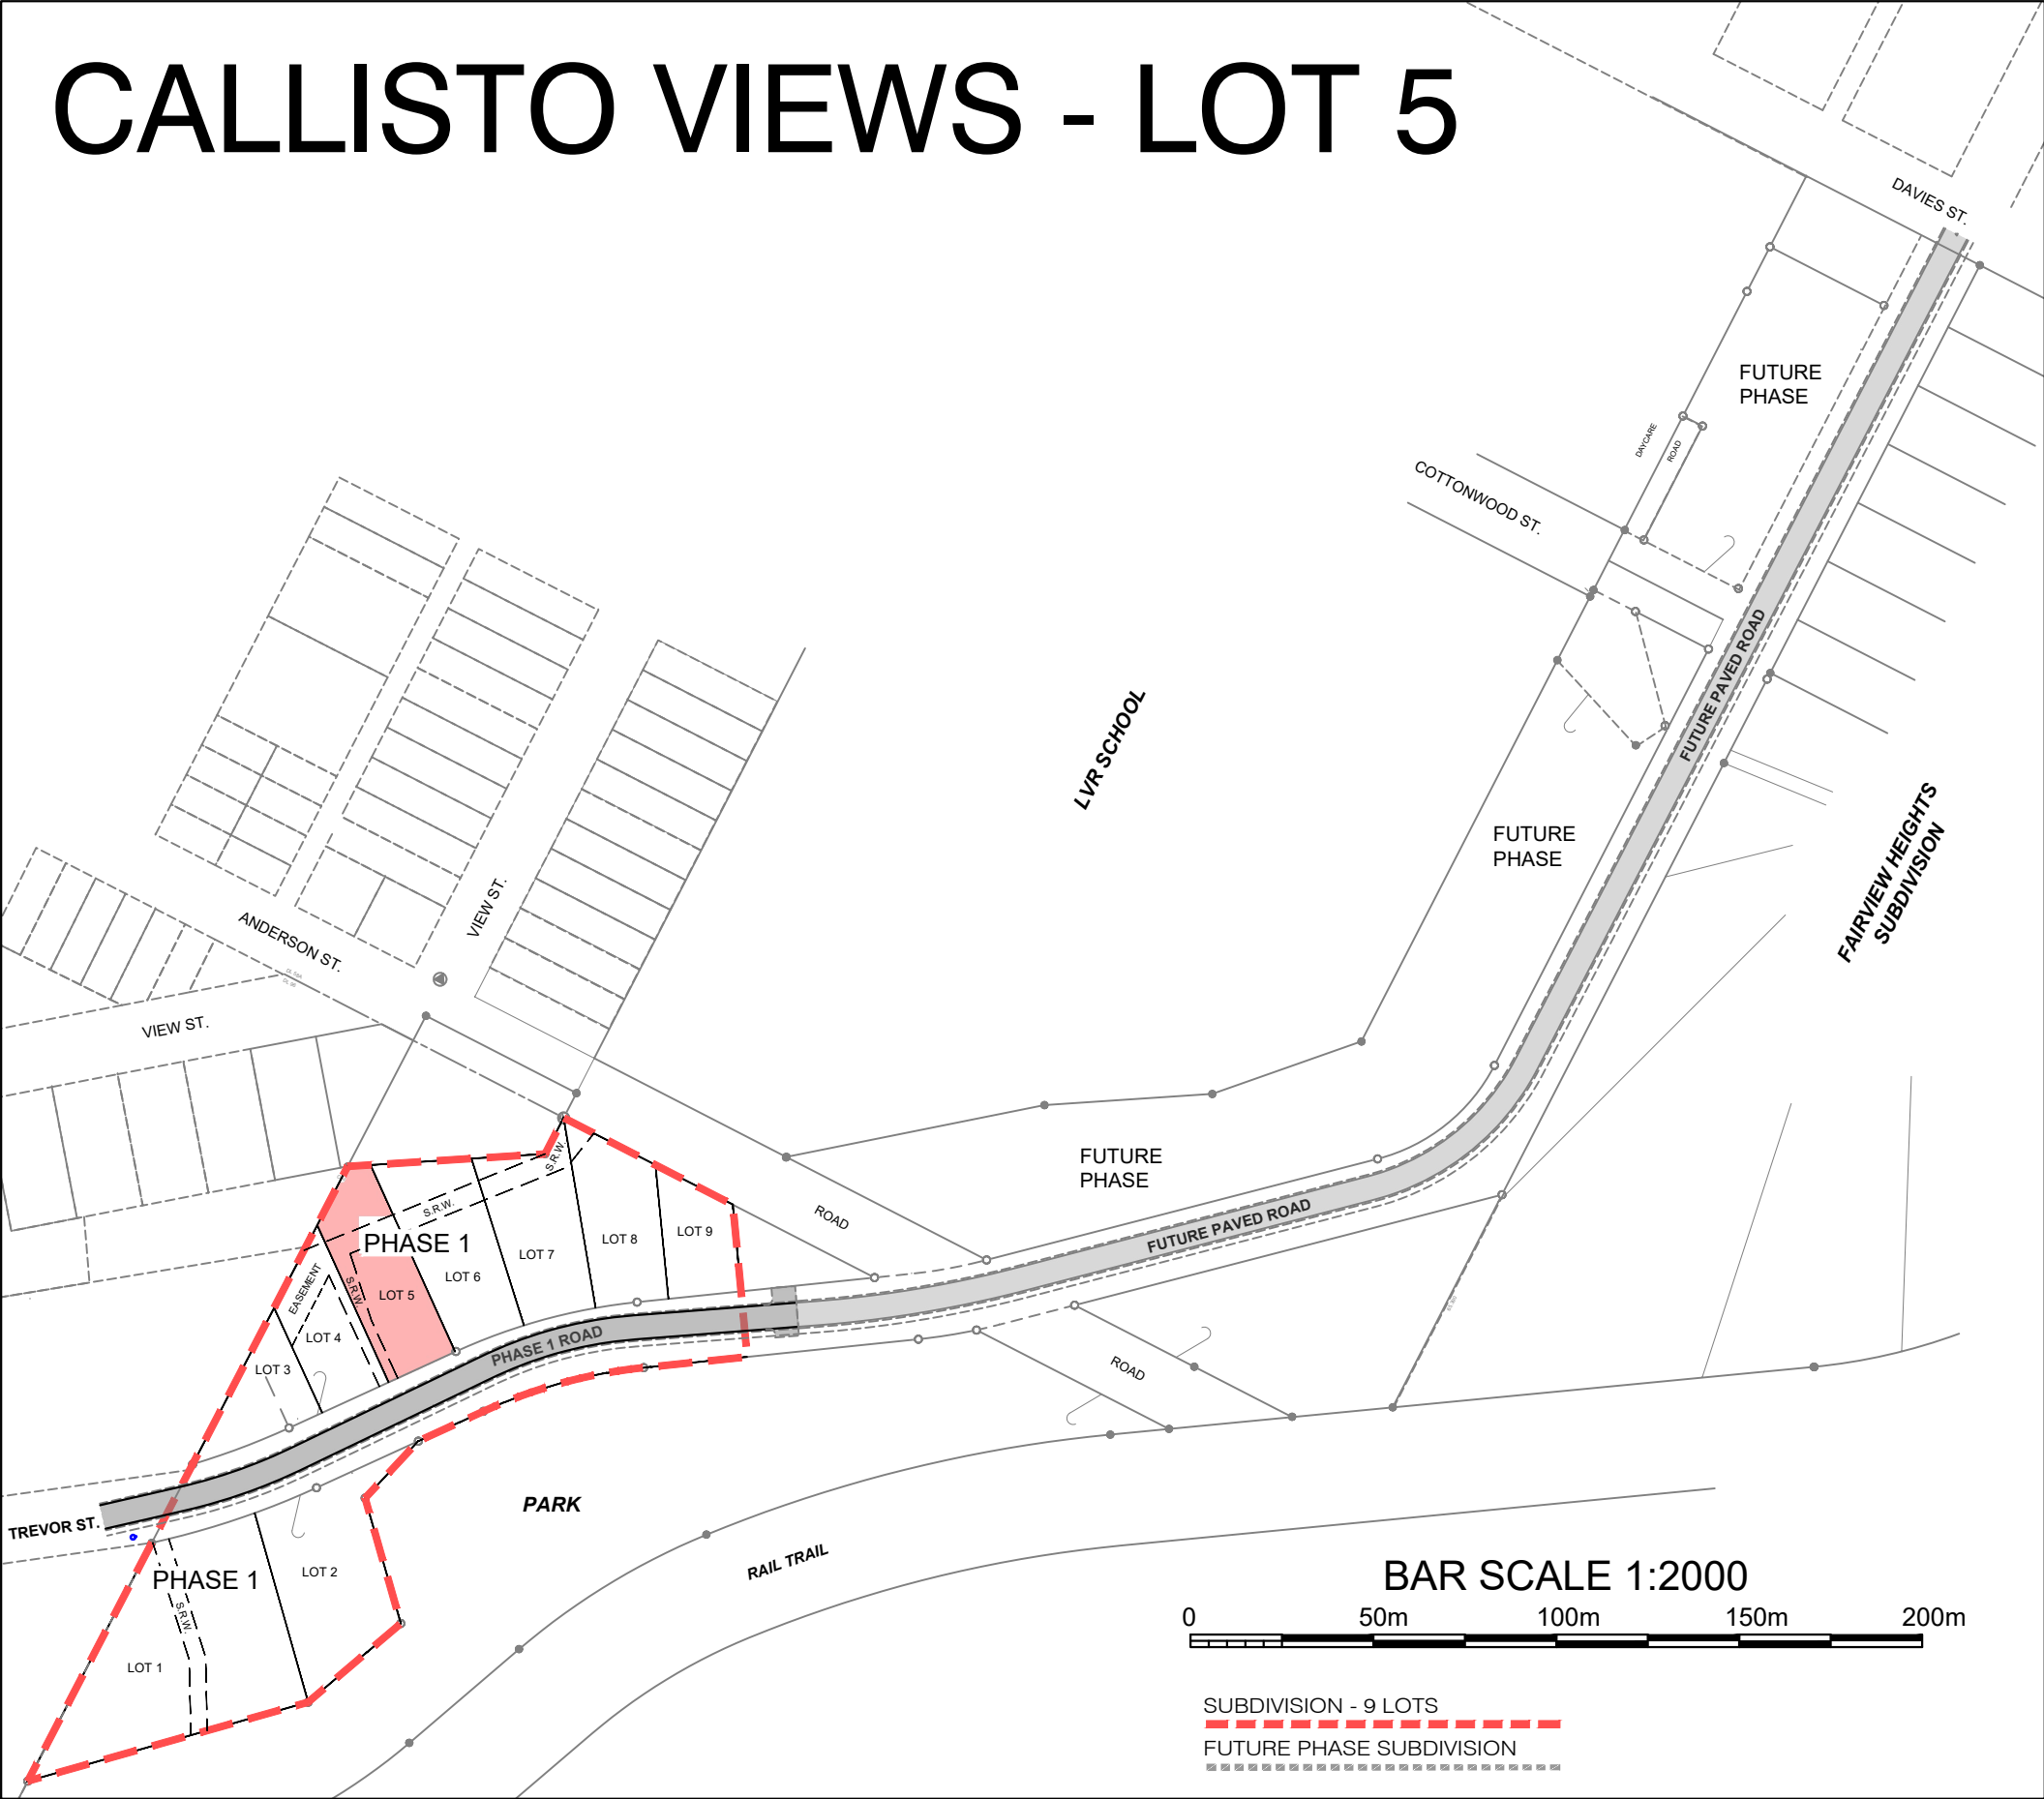

SUITE #3, 385 BAKER STREET
NELSON, BC V1L 4H6

PH (250) 354-7683
email: info@snteng.ca

**FOR INFORMATION
ONLY**
2026/09/25

DRAWING INDEX:

- 5000 LOT 5 - PLAN VIEW w/ 1m CONTOURS
- 5001 LOT 5 - AS-BUILT GROUNDLINE PROFILE (1:250)
- 5002 LOT 5 - AS-BUILT GROUNDLINE PROFILE (1:150)

SUBDIVISION LEGAL DESCRIPTION:
LOT A, PLAN EPP143242 DL183

SCALE: AS NOTED

Designed =

Drawn M. DAVIES

Date _____

Date 2026/03/16

PROJECT: TREVOR - DAVIES CONNECTOR - PHASE 1

PARCEL: LOT 1 DISTRICT LOT 183 KOOTENAY DISTRICT PID: 017-853-681
PLAN NEP19895 EXCEPT PLAN NEP73554

DRAWING TITLE: LOT 5 - AS-BUILT PLAN VIEW w/ 1m CONTOURS

ORIGINAL SIGNED and SEALED BY:

APPROVED BY:

DESIGN ENGINEER


SNT PROJECT No. _____

DRAWING No.

G No. _____

10



TREVOR ST. EXTENSION PROJECT PHASE 1
CALLISTO VIEWS SUBDIVISION
LOT-5 PLAN Scale 1:250

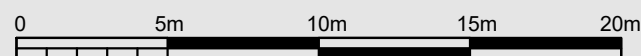

DISTANCES ARE IN METERS

**FOR INFORMATION
ONLY**

2026/09/25

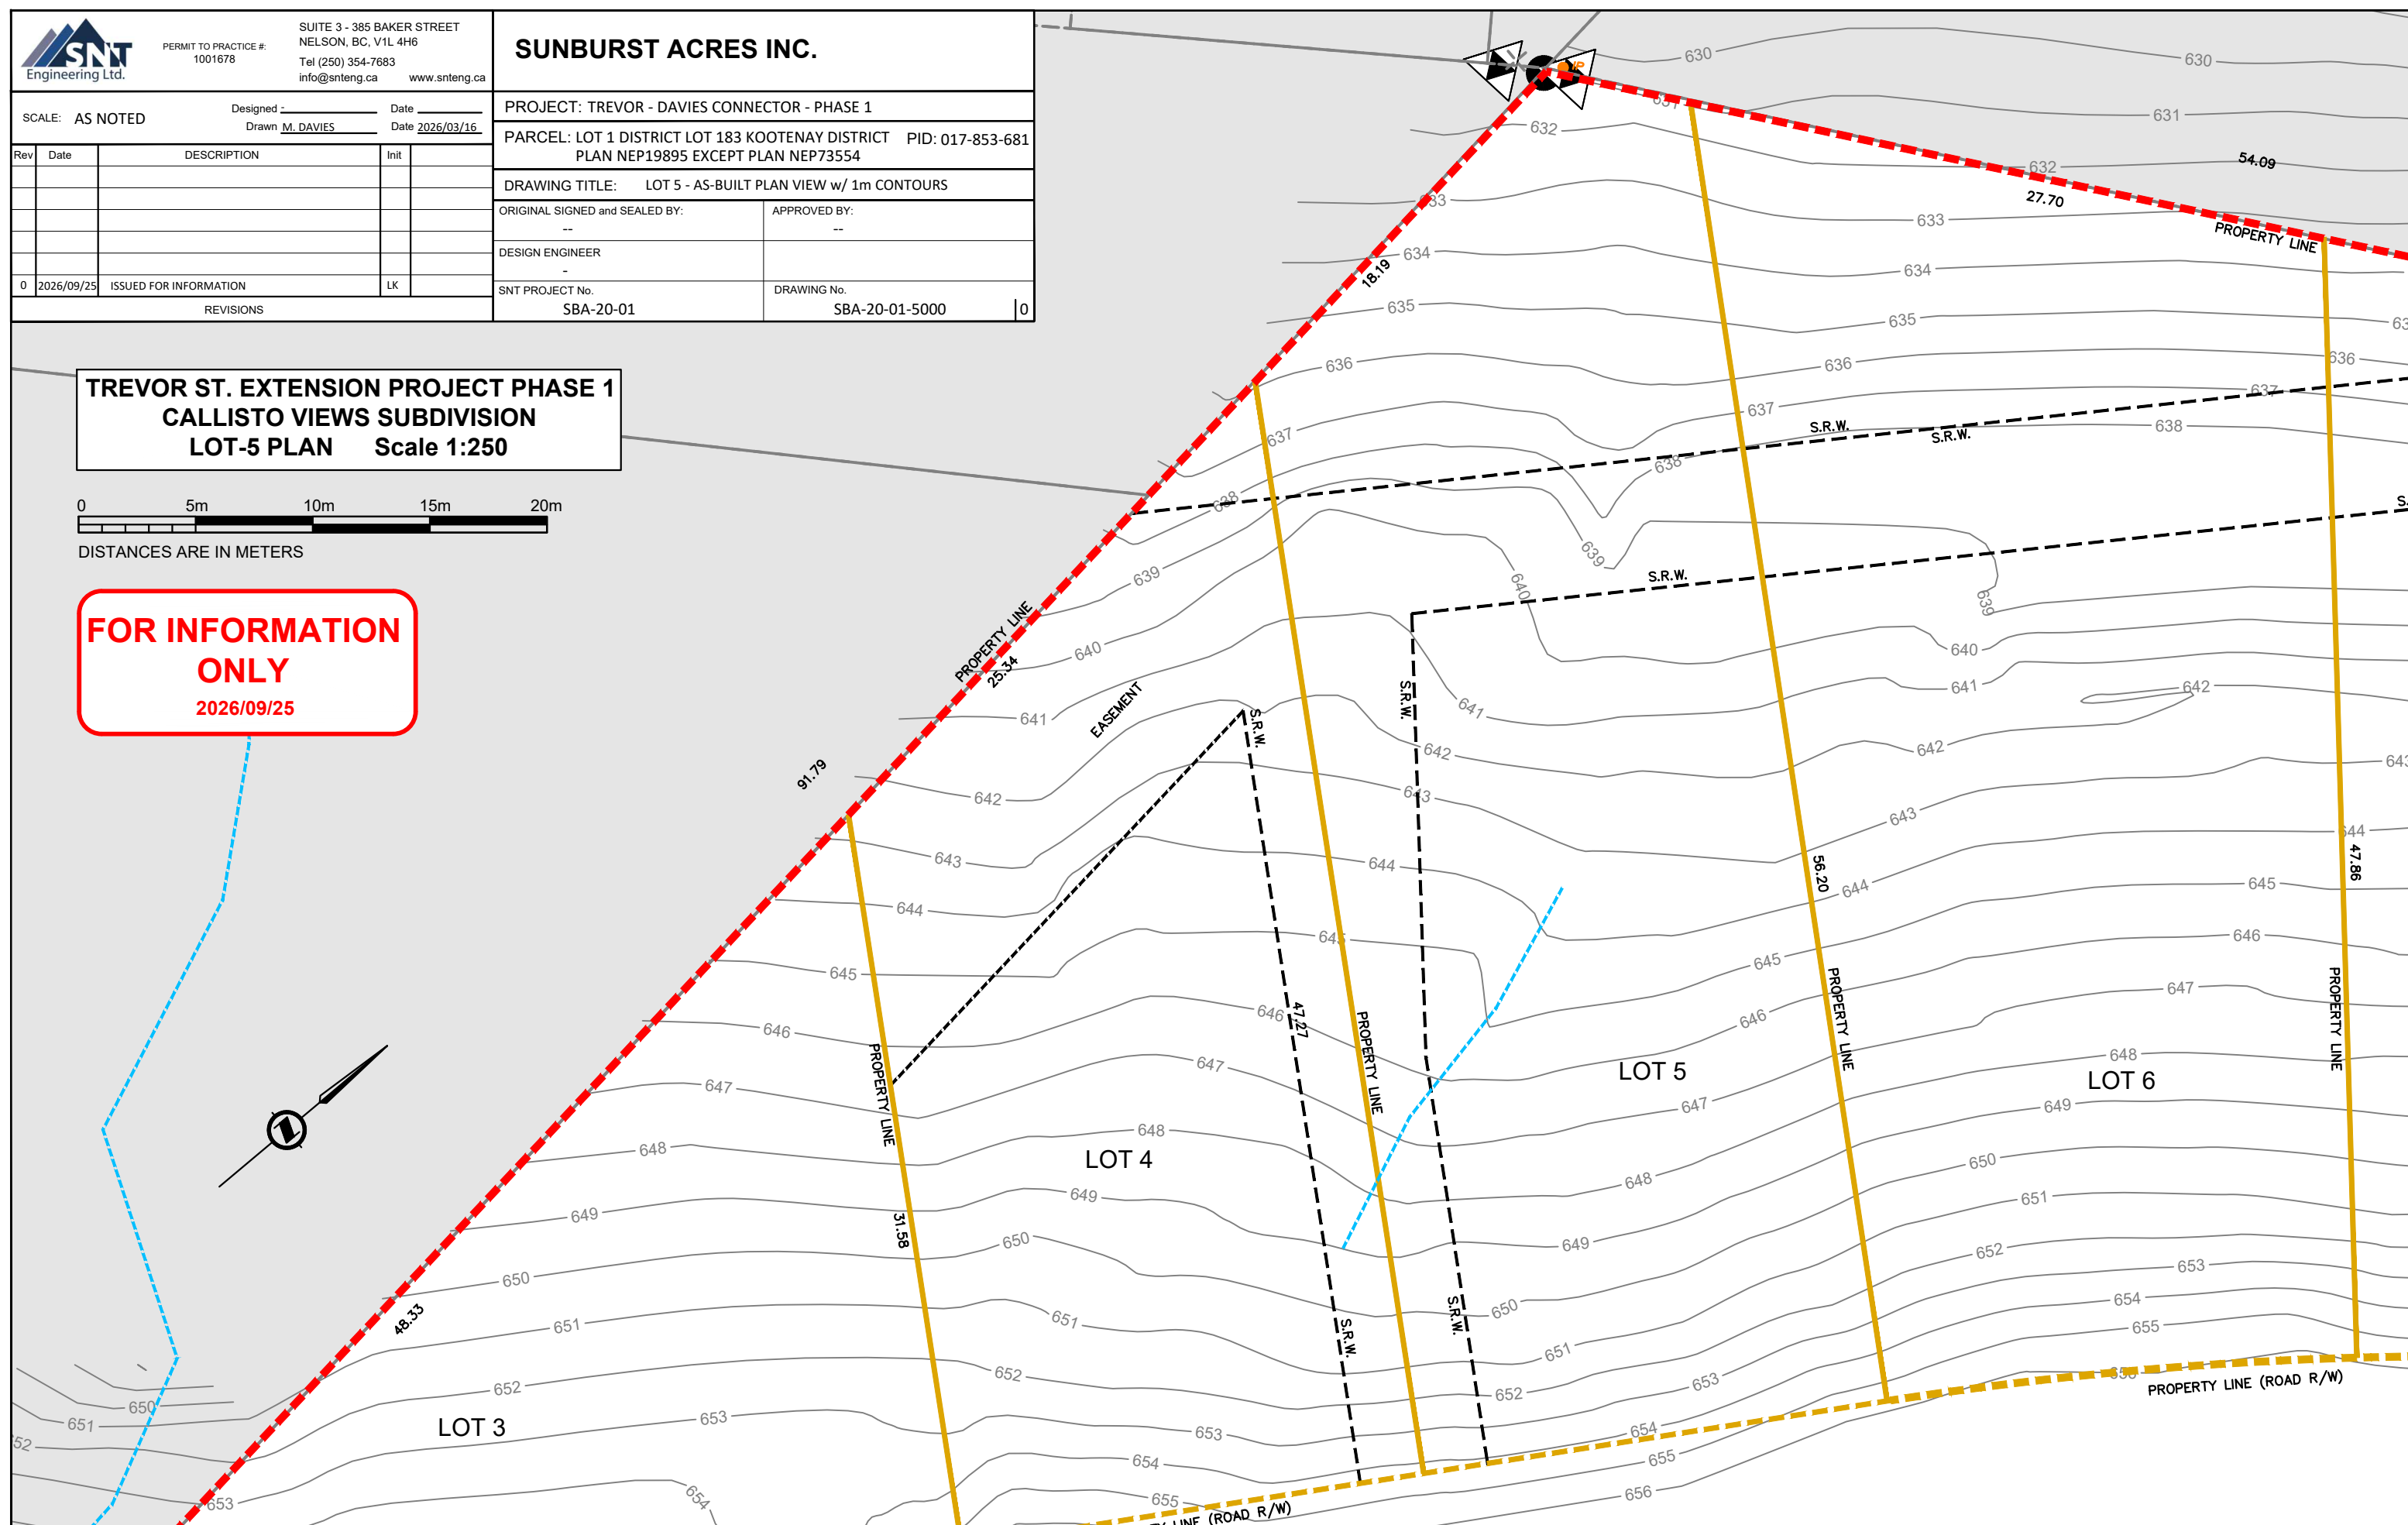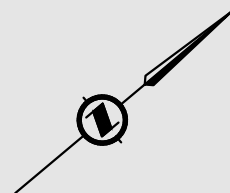



PERMIT TO PRACTICE #:
1001678

SUITE 3 - 385 BAKER STREET
NELSON, BC, V1L 4H6
Tel (250) 354-7683
info@snteng.ca www.snteng.ca

SUNBURST ACRES INC.

PROJECT: TREVOR - DAVIES CONNECTOR - PHASE 1

PARCEL: LOT 1 DISTRICT LOT 183 KOOTENAY DISTRICT PID: 017-853-681
PLAN NEP19895 EXCEPT PLAN NEP73554

DRAWING TITLE: LOT 5 - AS-BUILT GROUND PROFILE

ORIGINAL SIGNED and SEALED BY: APPROVED BY:

DESIGN ENGINEER

SNT PROJECT No. DRAWING No.

SBA-20-01 SBA-20-01-5001

SCALE: AS NOTED

Designed - Date

Drawn M. DAVIES Date 2026/03/16

Rev	Date	DESCRIPTION	Init
0	2026/09/25	ISSUED FOR INFORMATION	LK

REVISIONS

FOR INFORMATION
ONLY
2026/09/25

TREVOR ST. EXTENSION PROJECT PHASE 1
CALLISTO VIEWS SUBDIVISION
LOT-5 PROFILE Scale 1:250

PLAN VIEW OF LOT 5

scale 1:1000

