


CALLISTO VIEWS - LOT 7

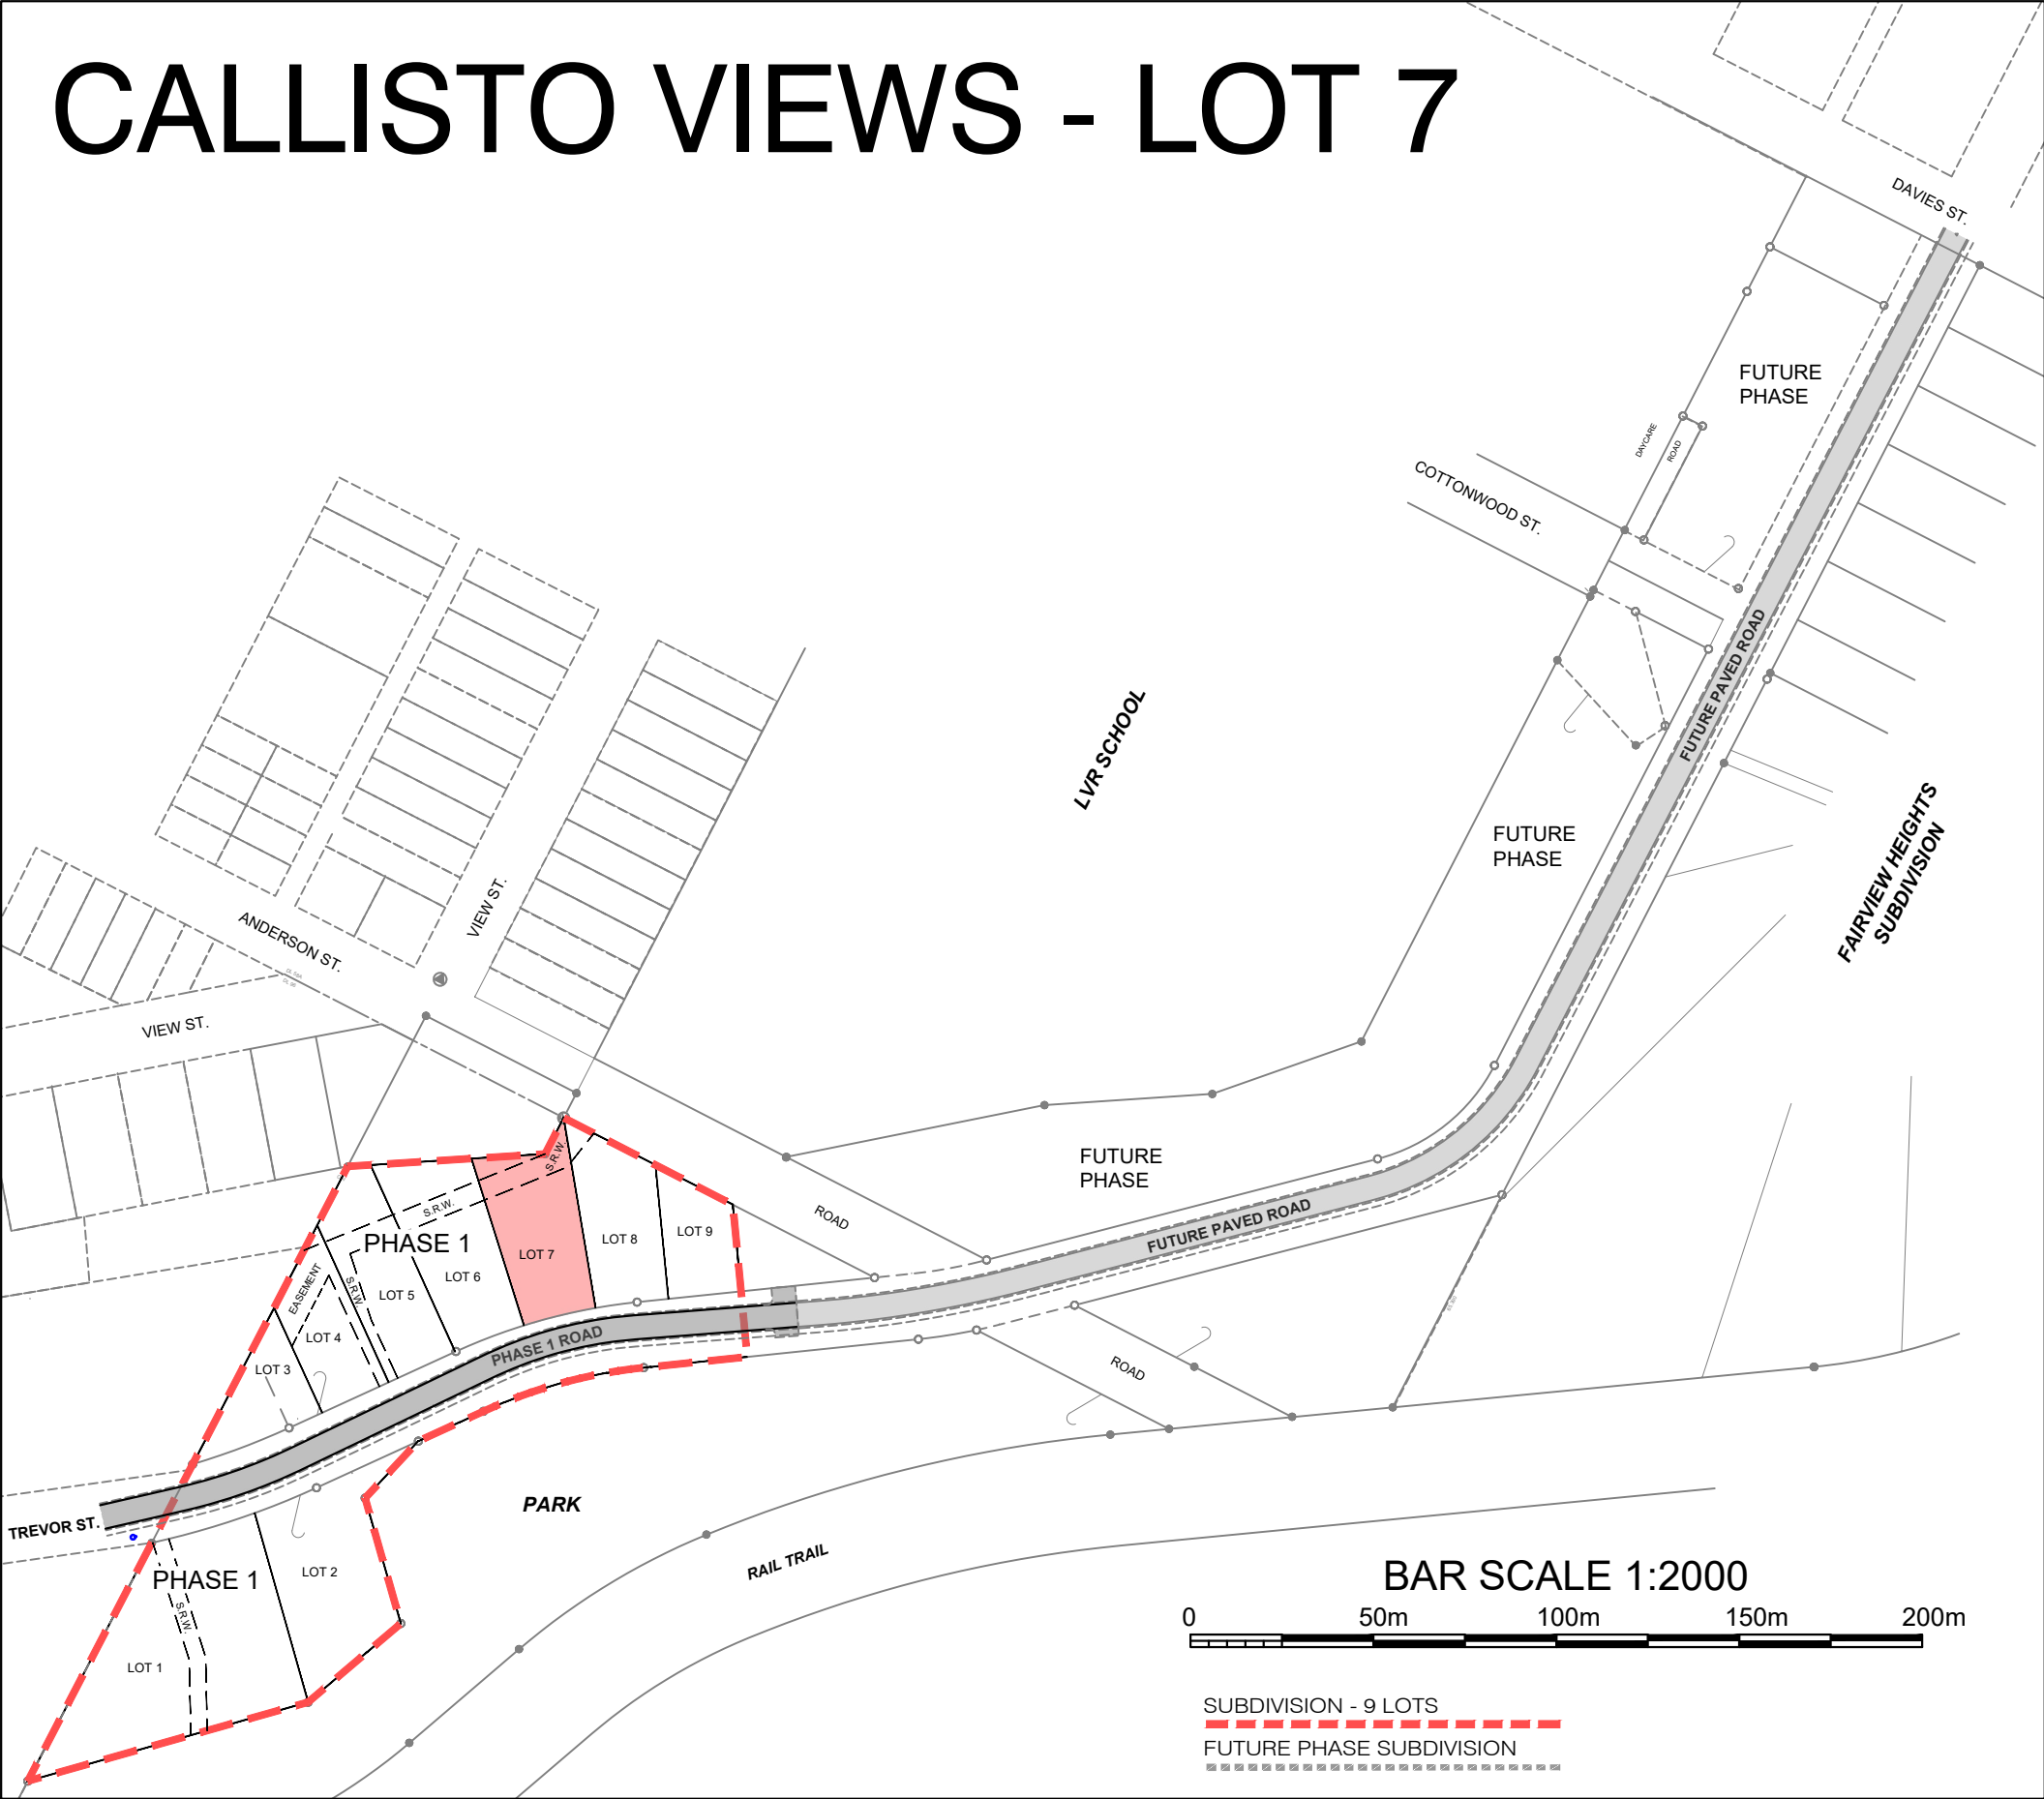

SUITE #3, 385 BAKER STREET
NELSON, BC V1L 4H6


PH (250) 354-7683
email: info@snteng.ca

**FOR INFORMATION
ONLY**
2026/09/25

DRAWING INDEX:

- 7000 LOT 7 - PLAN VIEW w/ 1m CONTOURS
- 7001 LOT 7 - AS-BUILT GROUNDLINE PROFILE (1:250)
- 7002 LOT 7 - AS-BUILT GROUNDLINE PROFILE (1:150)

SUBDIVISION LEGAL DESCRIPTION:
LOT A, PLAN EPP143242 DL183

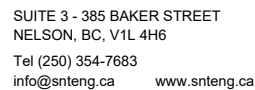

SUNBURST ACRES INC.

SCALE: AS NOTED

Designed -

Date _____

Drawn M. DAVIES

Date 2026/09/25

PROJECT: TREVOR - DAVIES CONNECTOR - PHASE 1

PARCEL: LOT 1 DISTRICT LOT 183 KOOTENAY DISTRICT PID: 017-853-681
PLAN NEP19895 EXCEPT PLAN NEP73554

DRAWING TITLE: LOT 7 - AS-BUILT PLAN VIEW w/ 1m CONTOURS

ORIGINAL SIGNED and SEALED BY:

APPROVED BY:

DESIGN ENGINEER


--	--

SNT PROJECT No.

DRAWING No.

TREVOR ST. EXTENSION PROJECT PHASE 1
CALLISTO VIEWS SUBDIVISION
LOT-7 PLAN Scale 1:250

**FOR INFORMATION
ONLY**
2026/09/25

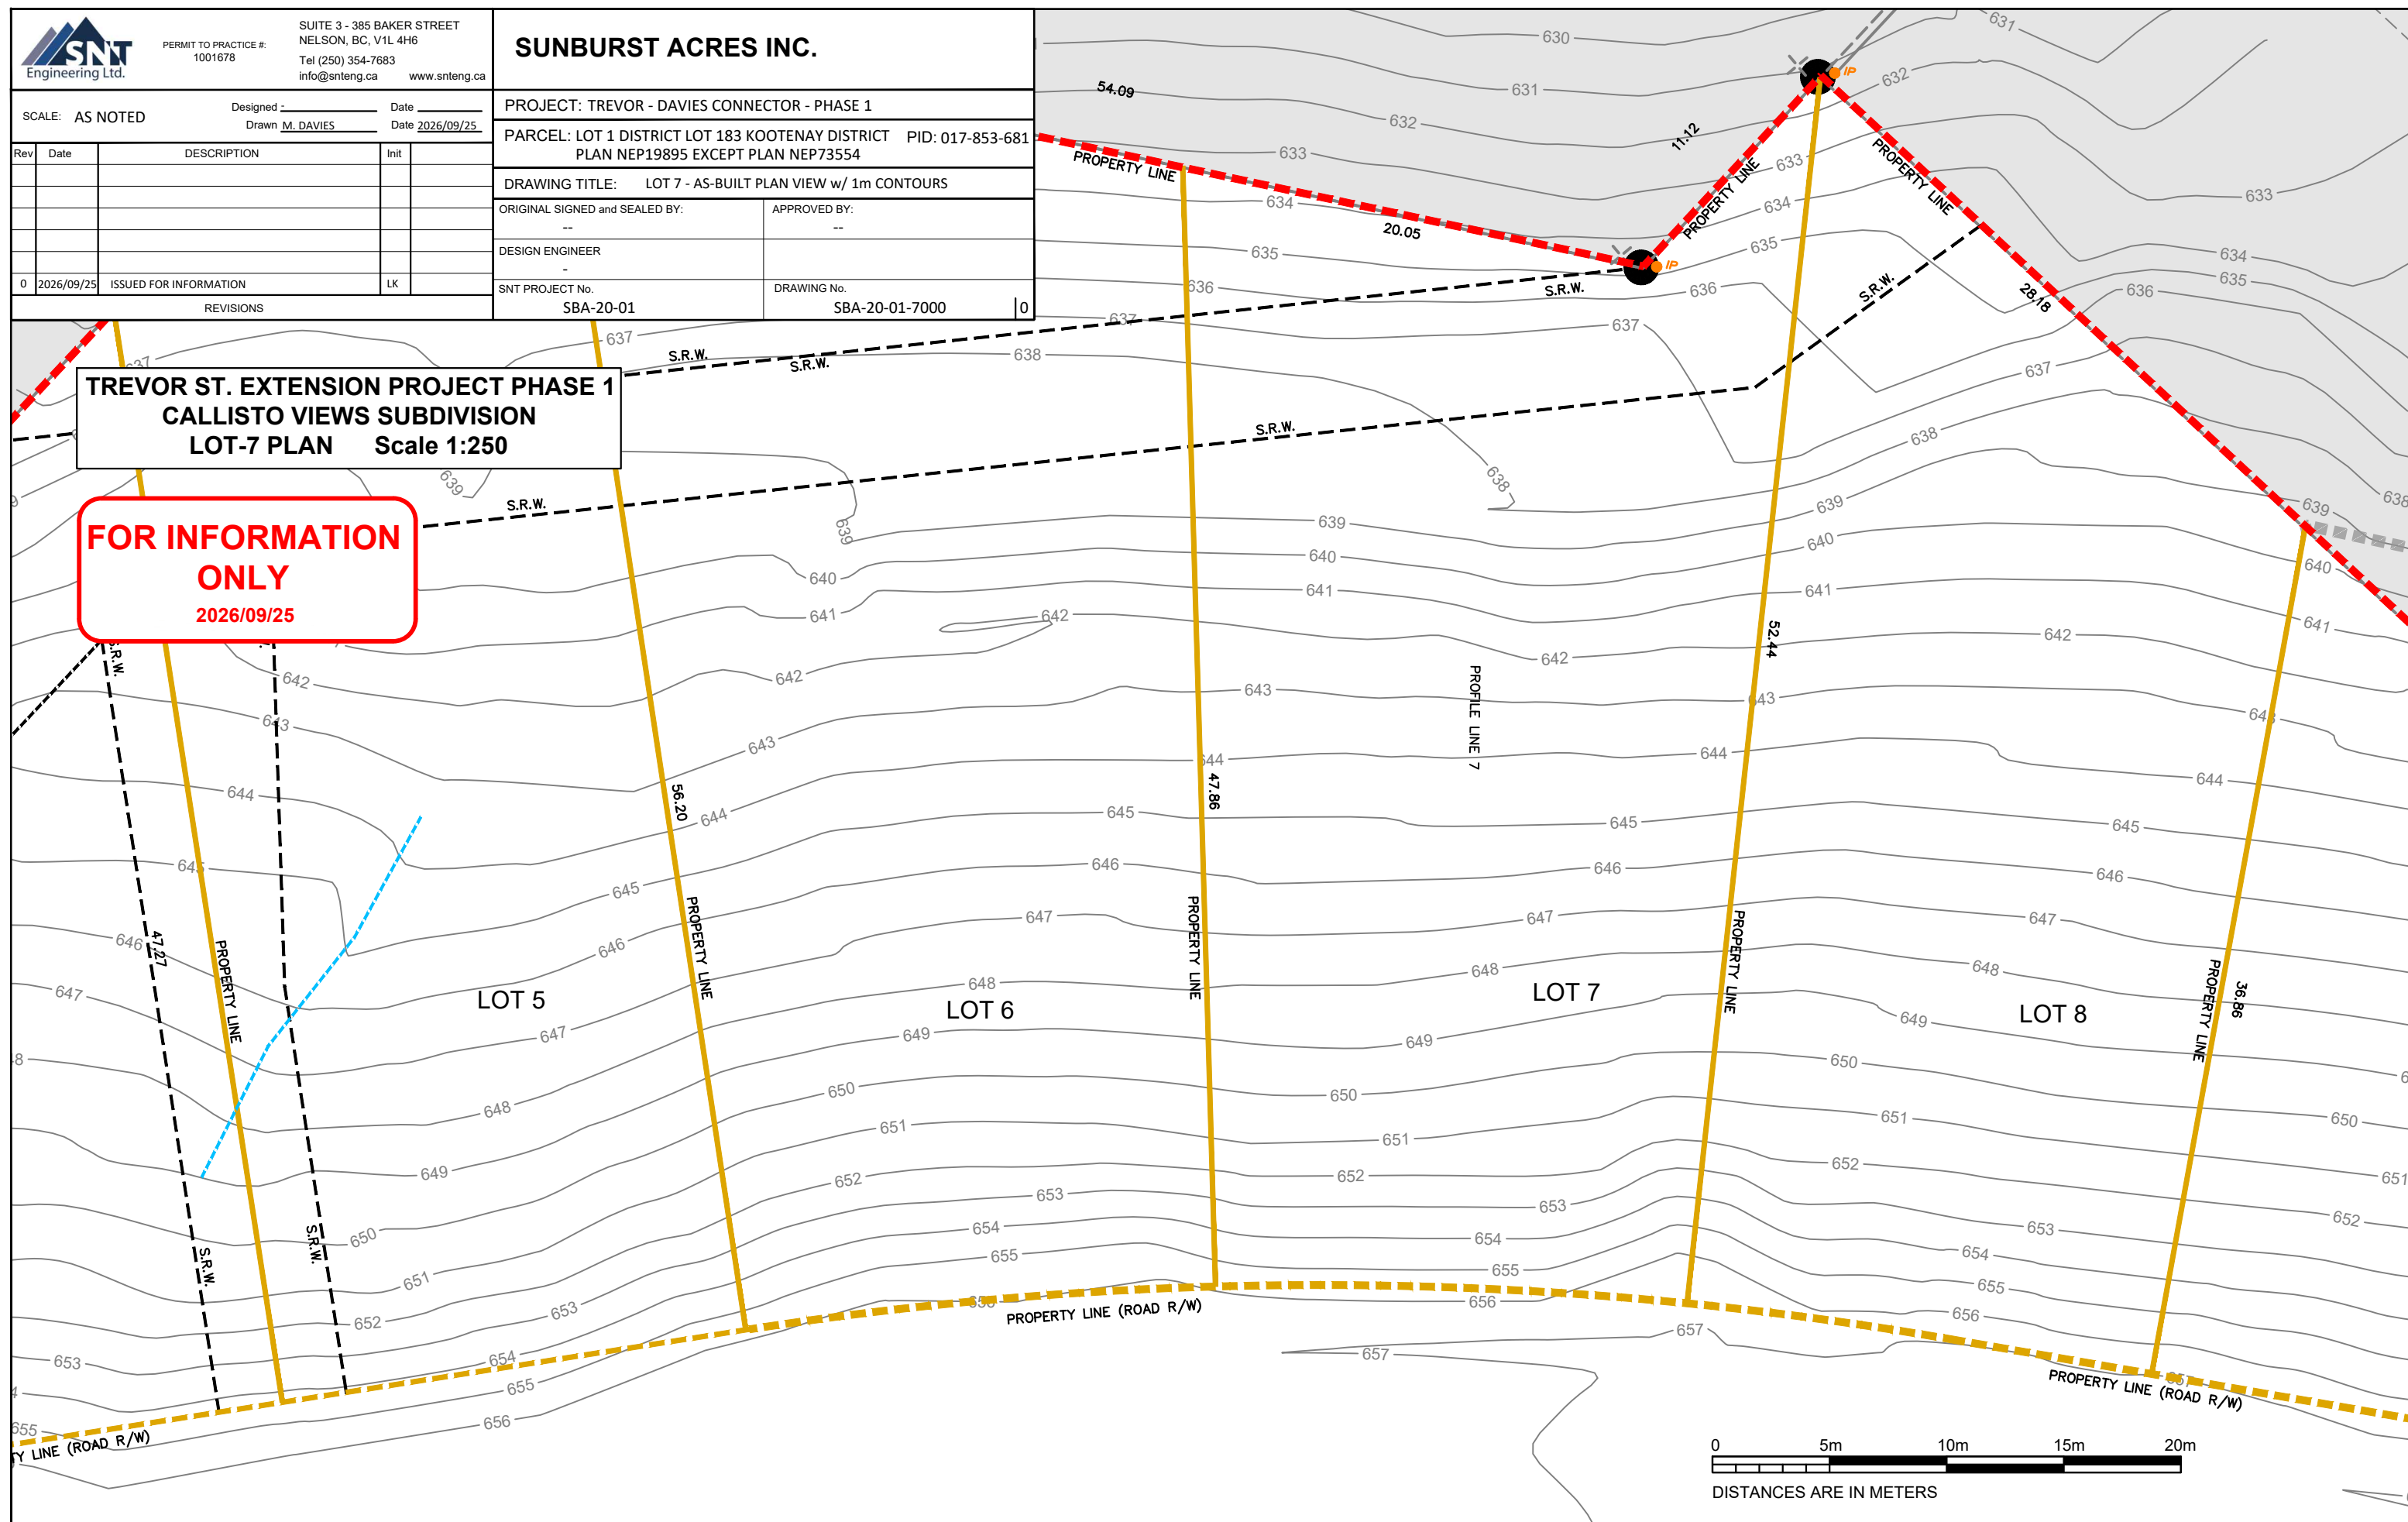


		SUITE 3 - 385 BAKER STREET NELSON, BC, V1L 4H6 Tel (250) 354-7683 info@snteng.ca www.snteng.ca	
PERMIT TO PRACTICE #: 1001678		SUNBURST ACRES INC.	
SCALE: AS NOTED		PROJECT: TREVOR - DAVIES CONNECTOR - PHASE 1	
Designed - Drawn M. DAVIES		Date 2026/09/25	
Rev	Date	DESCRIPTION	Init
0	2026/09/25	ISSUED FOR INFORMATION	LK
REVISIONS		SNT PROJECT No. SBA-20-01 DRAWING No. SBA-20-01-7001	
		0	


PARCEL: LOT 1 DISTRICT LOT 183 KOOTENAY DISTRICT PID: 017-853-681 PLAN NEP19895 EXCEPT PLAN NEP73554	
DRAWING TITLE: LOT 7 - AS-BUILT GROUND PROFILE	
ORIGINAL SIGNED and SEALED BY: --	APPROVED BY: --
DESIGN ENGINEER -	
SNT PROJECT No. SBA-20-01	DRAWING No. SBA-20-01-7001

**FOR INFORMATION
ONLY**
2026/09/25

**TREVOR ST. EXTENSION PROJECT PHASE 1
CALLISTO VIEWS SUBDIVISION
LOT-7 PROFILE Scale 1:250**

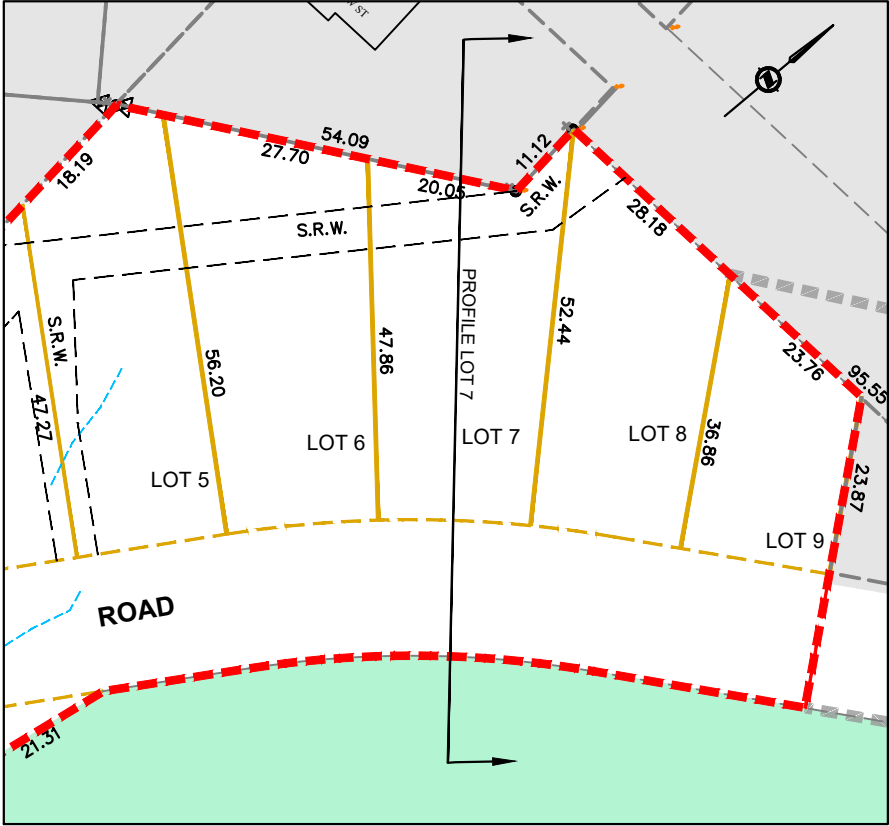

PLAN VIEW OF LOT 7 scale 1:1000

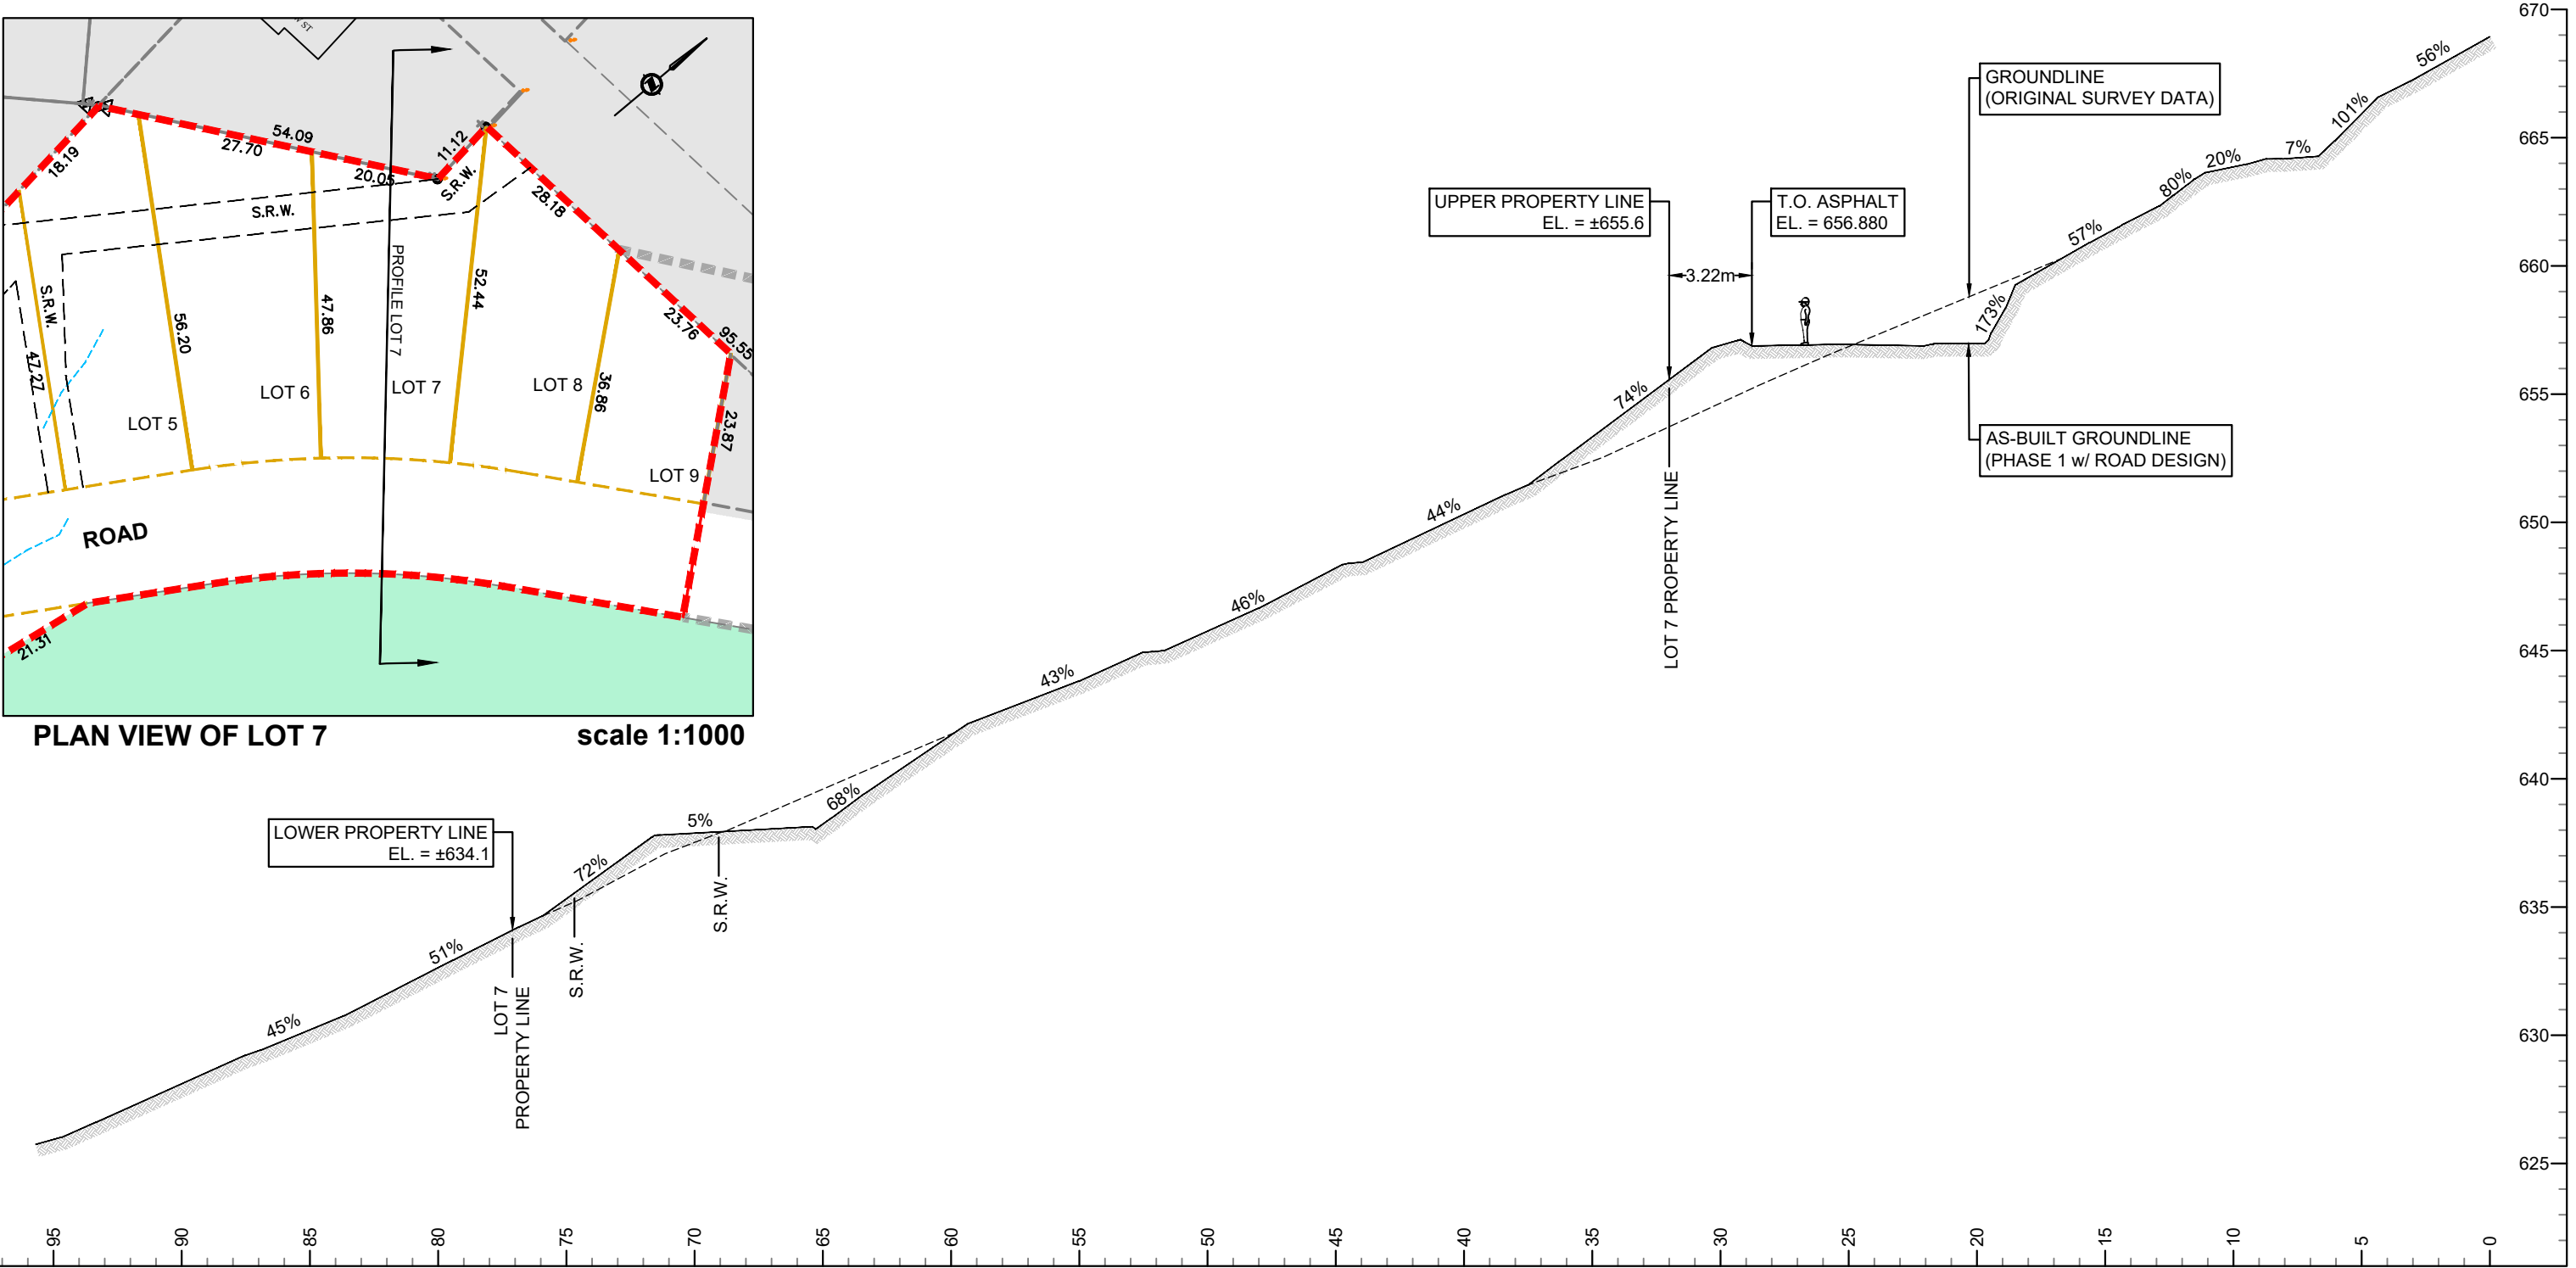

SUNBURST ACRES INC.

SCALE: AS NOTED

Designed -

Date _____

Drawn M. DAVIES

Date 2026/09/25

PROJECT: TREVOR - DAVIES CONNECTOR - PHASE 1

PARCEL: LOT 1 DISTRICT LOT 183 KOOTENAY DISTRICT PID: 017-853-681
PLAN NEP19895 EXCEPT PLAN NEP73554

DRAWING TITLE: LOT 7 - AS-BUILT GROUND PROFILE

ORIGINAL SIGNED and SEALED BY:

APPROVED BY:

DESIGN ENGINEER

--	--

SNT PROJECT №

DRAWING No.

SBA-20-01-7002

FOR INFORMATION

ONLY

2026/09/25

**TREVOR ST. EXTENSION PROJECT PHASE 1
CALLISTO VIEWS SUBDIVISION
LOT-7 PROFILE Scale 1:150**

