CALLISTO VIEWS - LOT 9

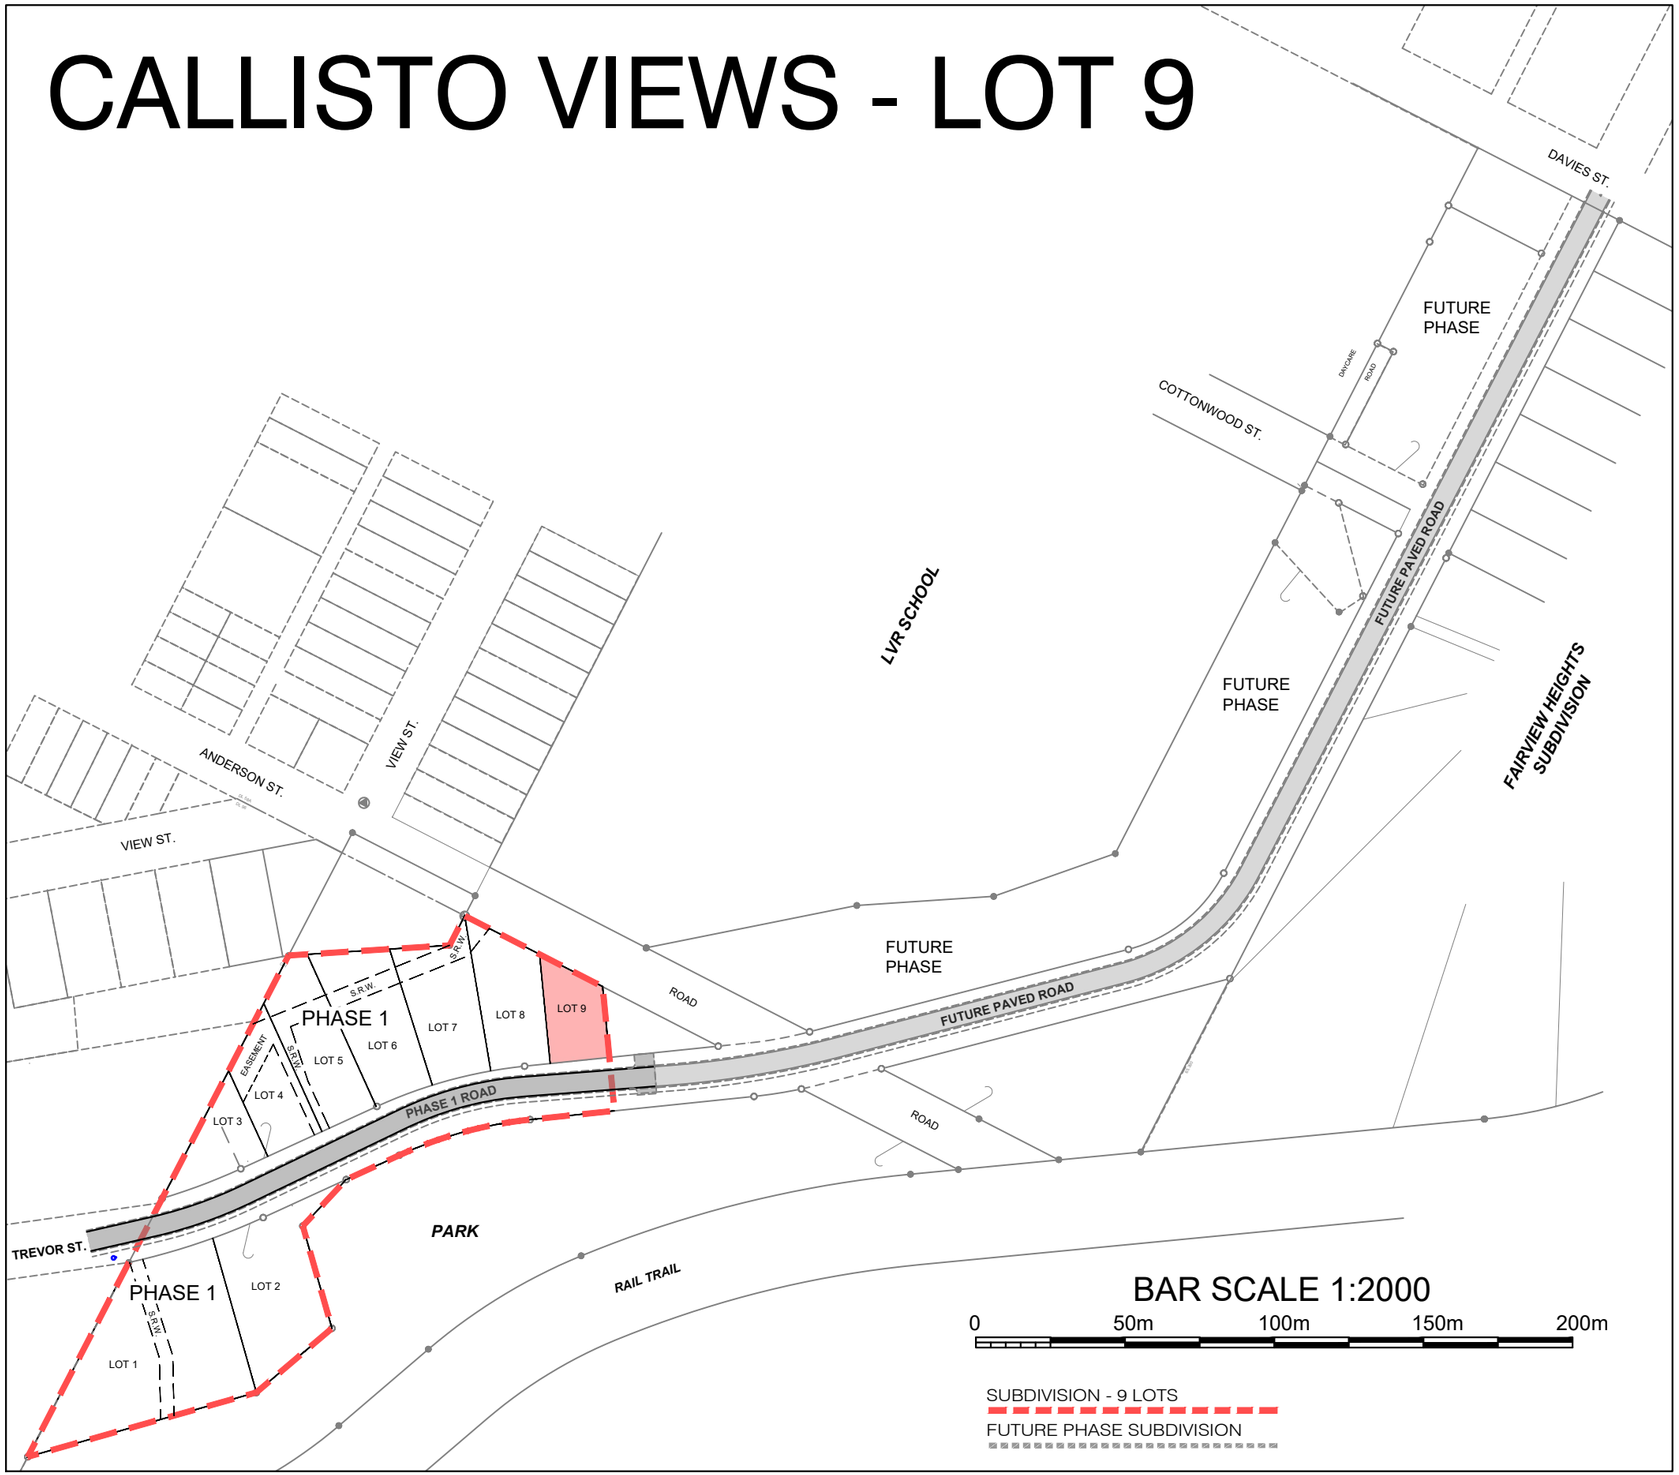

SUITE #3, 385 BAKER STREET
NELSON, BC V1L 4H6

PH (250) 354-7683
email: info@snteng.ca

FOR INFORMATION ONLY
2026/09/25

DRAWING INDEX:

9000 LOT 9 - PLAN VIEW w/ 1m CONTOURS
9001 LOT 9 - AS-BUILT GROUNDLINE PROFILE (1:250)
9002 LOT 9 - AS-BUILT GROUNDLINE PROFILE (1:150)

SUBDIVISION LEGAL DESCRIPTION:
LOT A, PLAN EPP143242 DL183

SNT Engineering Ltd.
PERMIT TO PRACTICE #: 1001678
SUITE 3 - 385 BAKER STREET
NELSON, BC, V1L 4H6
Tel (250) 354-7683
info@snteng.ca www.snteng.ca

SUNBURST ACRES INC.

SCALE: AS NOTED
Designed: _____ Date _____
Drawn M. DAVIES Date 2026/09/25

Rev	Date	DESCRIPTION	Init
0	2026/09/25	ISSUED FOR INFORMATION	LK

REVISIONS

PROJECT: TREVOR - DAVIES CONNECTOR - PHASE 1

PARCEL: LOT 1 DISTRICT LOT 183 KOOTENAY DISTRICT PLAN NEP19895 EXCEPT PLAN NEP73554 PID: 017-853-681

DRAWING TITLE: LOT 9 - AS-BUILT PLAN VIEW w/ 1m CONTOURS

ORIGINAL SIGNED and SEALED BY: --	APPROVED BY: --
DESIGN ENGINEER -	
SNT PROJECT No. SBA-20-01	DRAWING No. SBA-20-01-9000 | 0

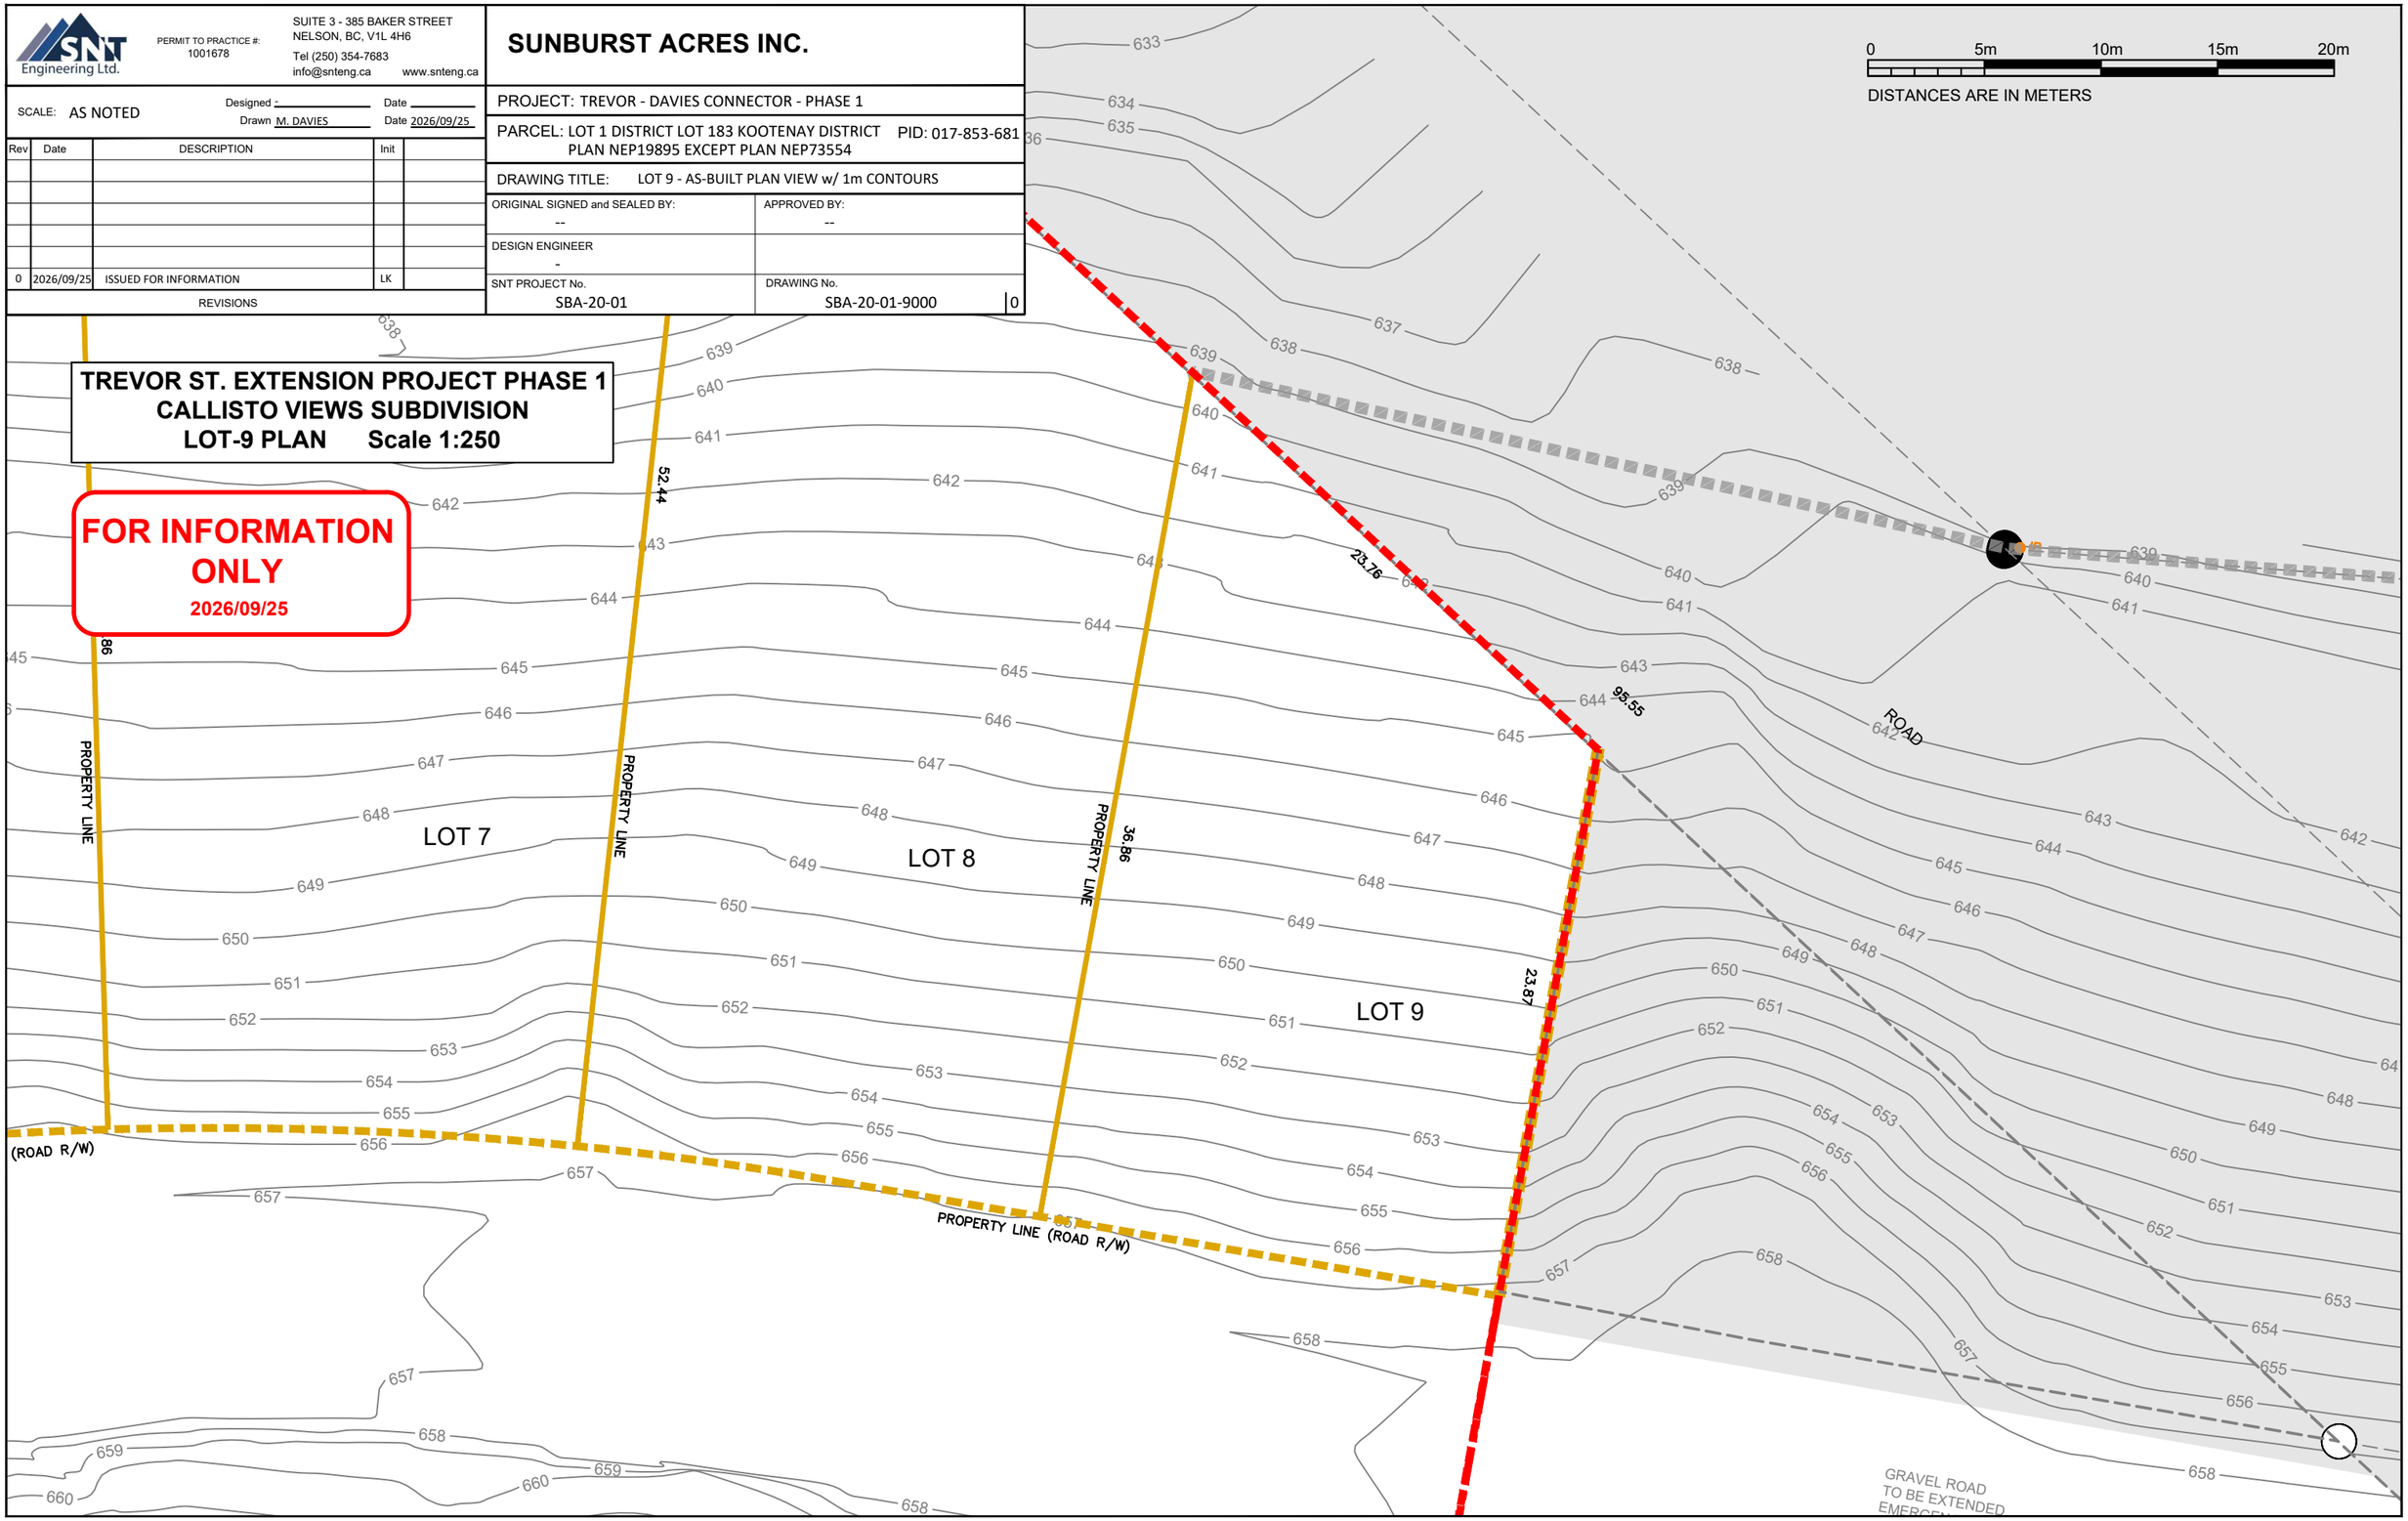

SNT Engineering Ltd.
PERMIT TO PRACTICE #: 1001678
SUITE 3 - 385 BAKER STREET
NELSON, BC, V1L 4H6
Tel (250) 354-7683
info@snteng.ca www.snteng.ca

SUNBURST ACRES INC.

SCALE: AS NOTED
Designed: _____ Date _____
Drawn M. DAVIES Date 2026/09/25

Rev	Date	DESCRIPTION	Init
0	2026/09/25	ISSUED FOR INFORMATION	LK

REVISIONS

PROJECT: TREVOR - DAVIES CONNECTOR - PHASE 1

PARCEL: LOT 1 DISTRICT LOT 183 KOOTENAY DISTRICT PLAN NEP19895 EXCEPT PLAN NEP73554 PID: 017-853-681

DRAWING TITLE: LOT 9 - AS-BUILT GROUND PROFILE

ORIGINAL SIGNED and SEALED BY: --
APPROVED BY: --
DESIGN ENGINEER -
SNT PROJECT No. SBA-20-01
DRAWING No. SBA-20-01-9001 | 0

FOR INFORMATION ONLY
2026/09/25

TREVOR ST. EXTENSION PROJECT PHASE 1
CALLISTO VIEWS SUBDIVISION
LOT-9 PROFILE Scale 1:250

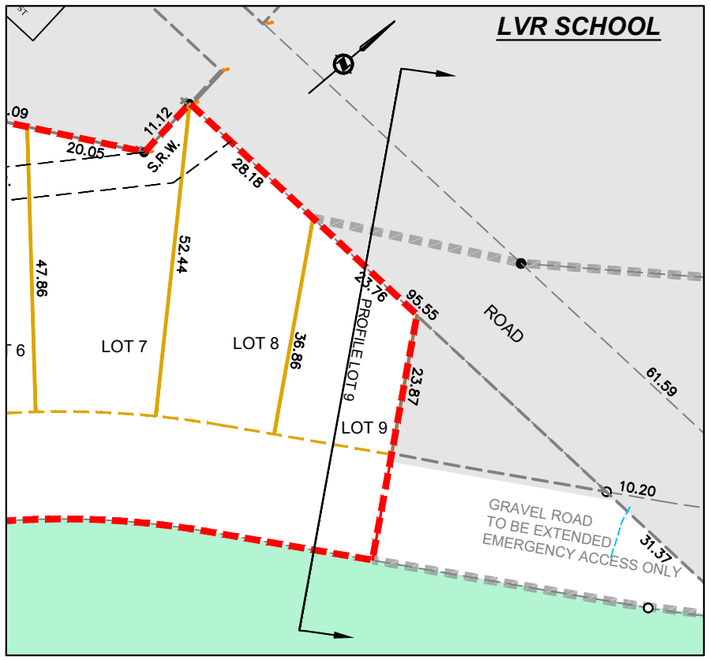

PLAN VIEW OF LOT 9 **scale 1:1000**

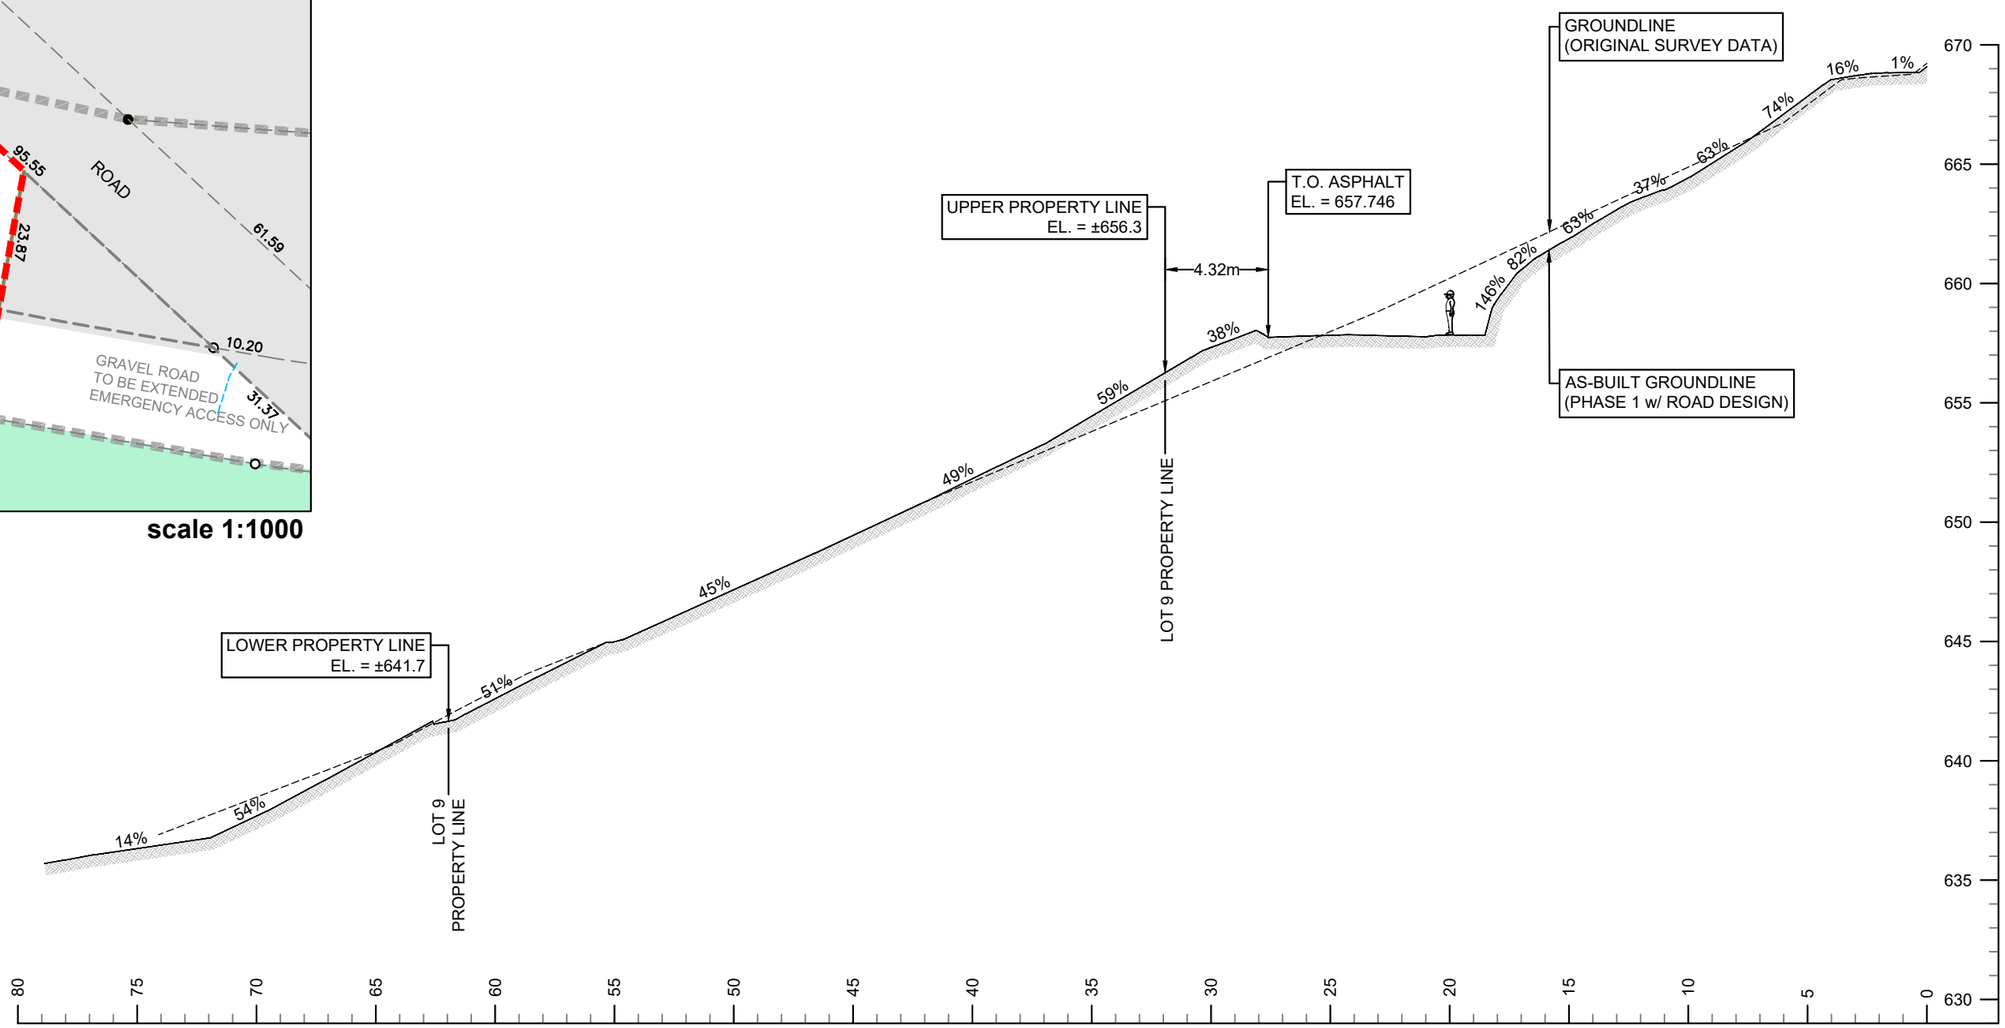

SNT Engineering Ltd.
PERMIT TO PRACTICE #: 1001678
SUITE 3 - 385 BAKER STREET
NELSON, BC, V1L 4H6
Tel (250) 354-7683
info@snteng.ca www.snteng.ca

SUNBURST ACRES INC.

SCALE: AS NOTED
Designed: _____ Date _____
Drawn M. DAVIES Date 2026/09/25

Rev	Date	DESCRIPTION	Init	
0	2026/09/25	ISSUED FOR INFORMATION	LK	

REVISIONS

PROJECT: TREVOR - DAVIES CONNECTOR - PHASE 1

PARCEL: LOT 1 DISTRICT LOT 183 KOOTENAY DISTRICT PLAN NEP19895 EXCEPT PLAN NEP73554 PID: 017-853-681

DRAWING TITLE: LOT 9 - AS-BUILT GROUND PROFILE

ORIGINAL SIGNED and SEALED BY: --	APPROVED BY: --
DESIGN ENGINEER -	
SNT PROJECT No. SBA-20-01	DRAWING No. SBA-20-01-9002 | 0

FOR INFORMATION ONLY
2026/09/25
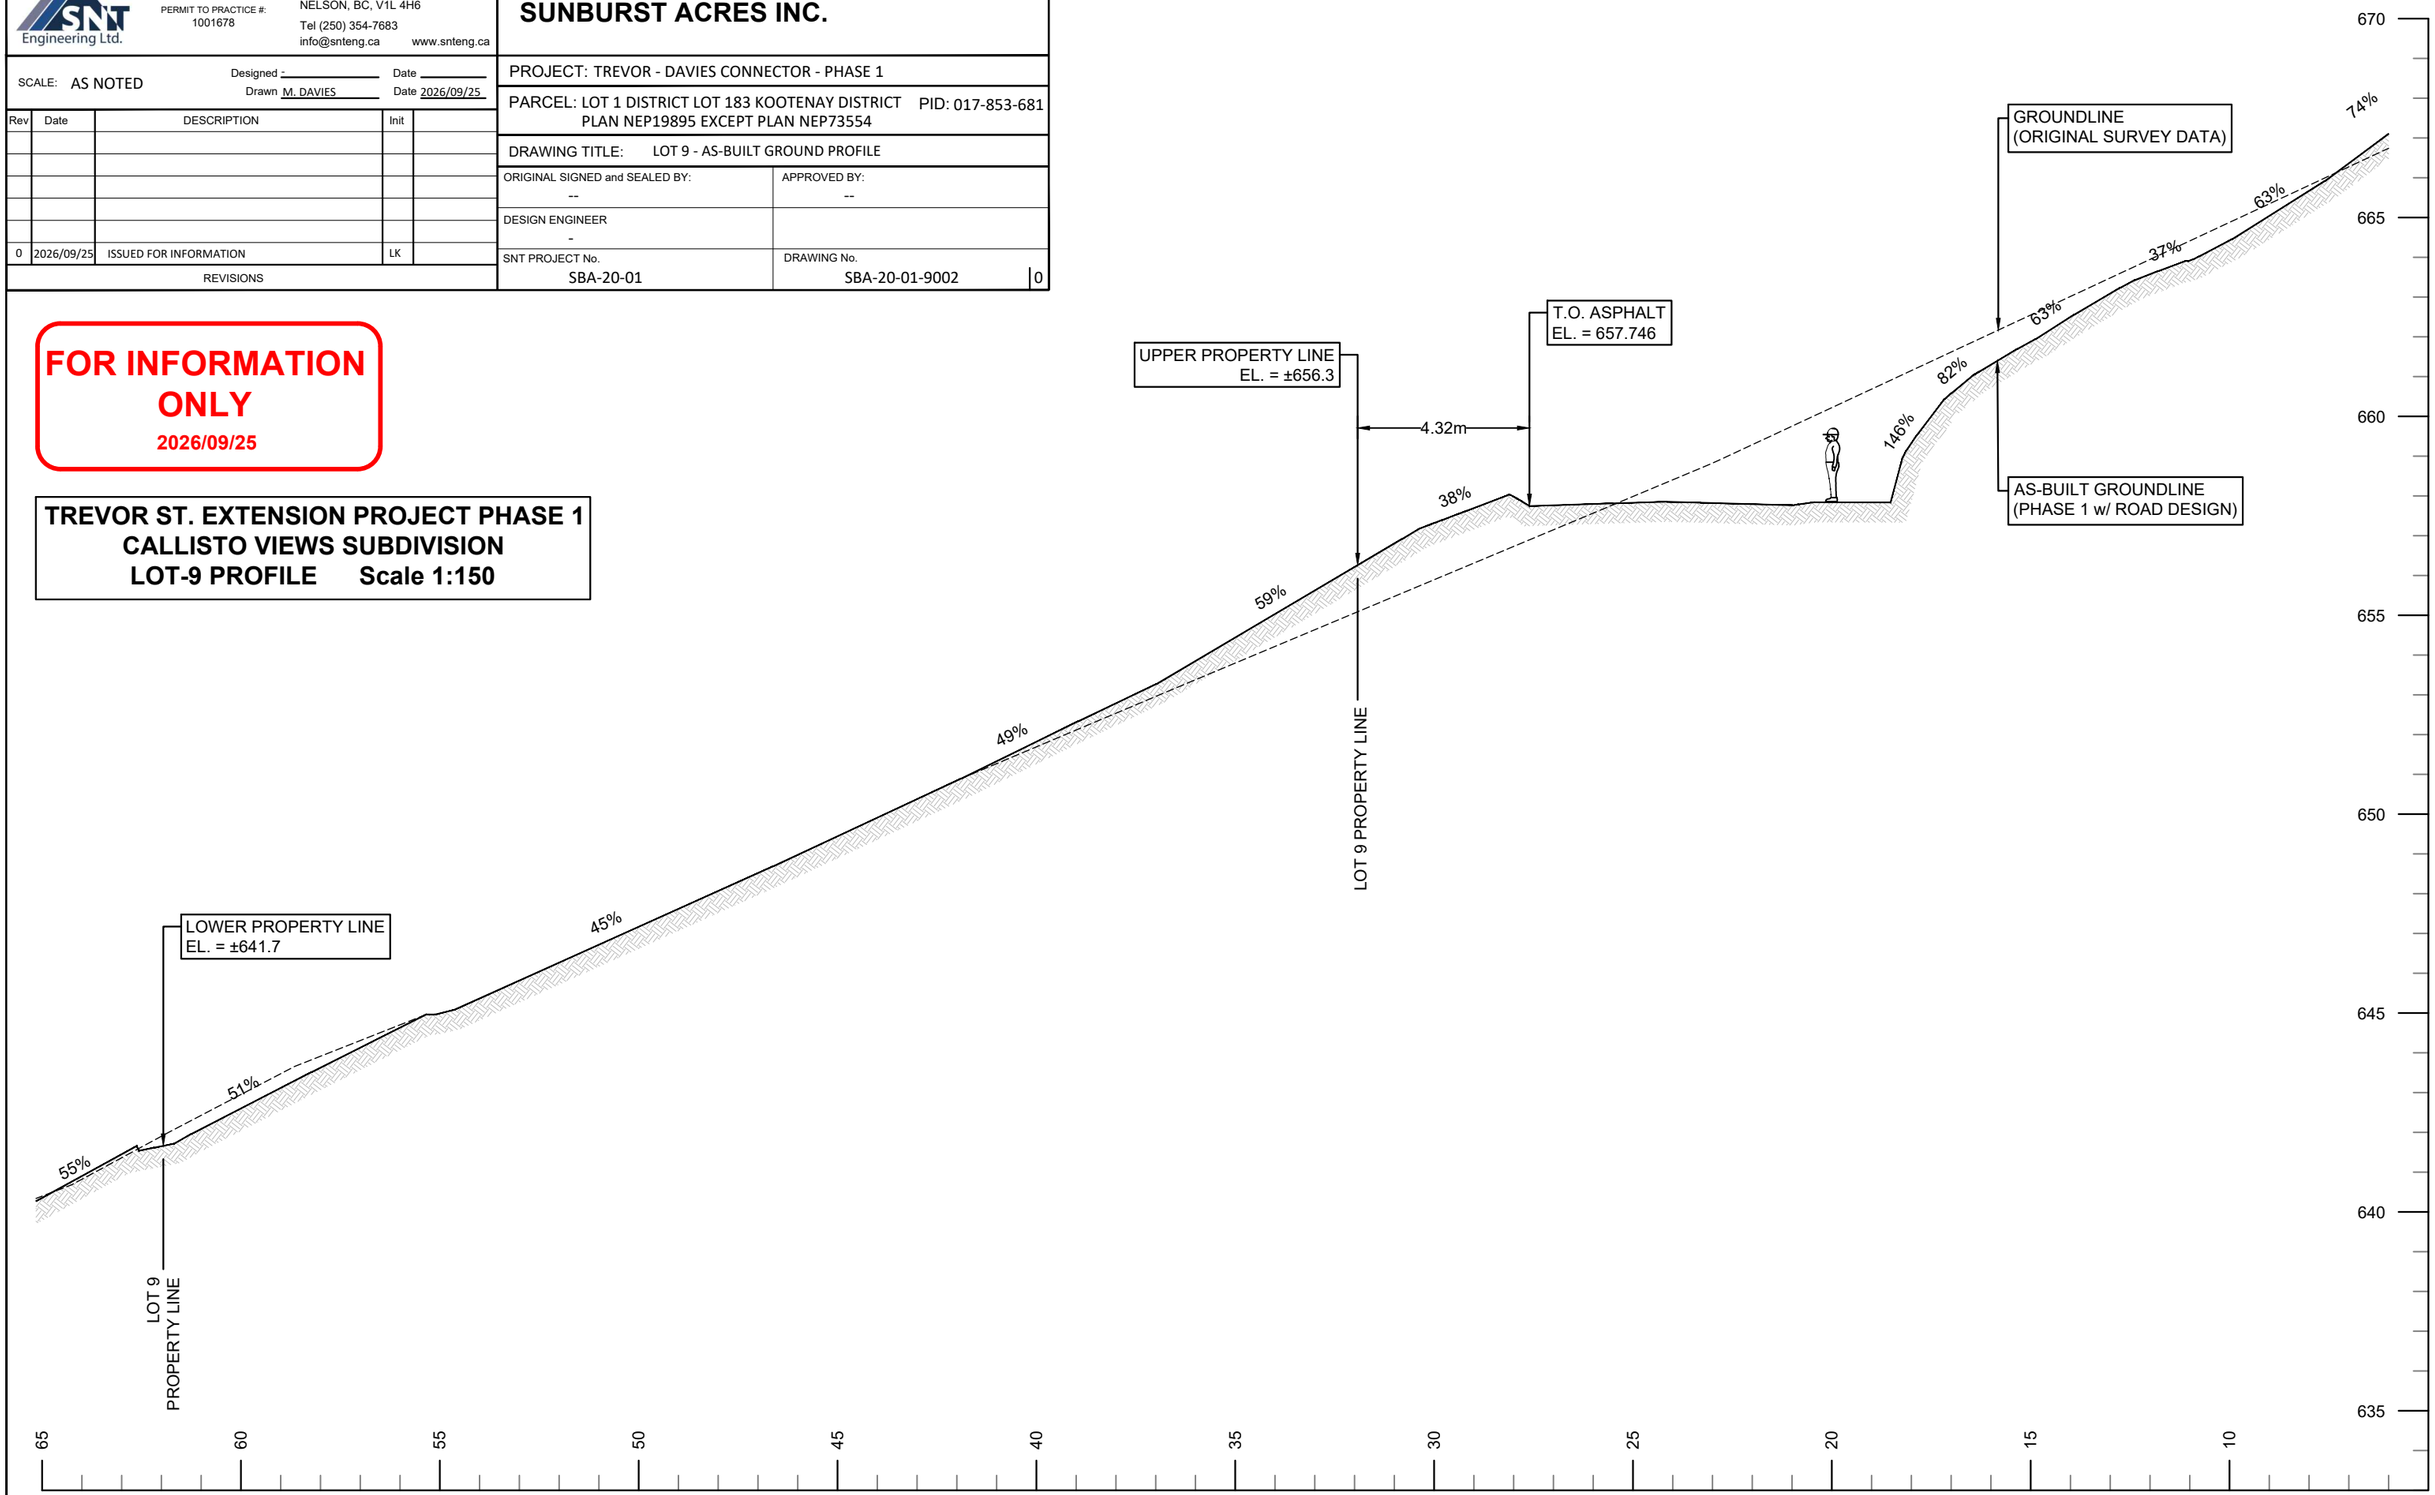
TREVOR ST. EXTENSION PROJECT PHASE 1
CALLISTO VIEWS SUBDIVISION
LOT-9 PROFILE Scale 1:150